

CODE

Jackson
L74
8-8-67

MISSISSIPPI
BOARD OF WATER COMMISSIONERS
416 North State Street
Jackson, Mississippi 39201

WATER WELL DRILLERS LOG

8-8

date well completed

1967 Colville Water Supply Jackson

firm name

county well located

LANDOWNER: <u>Murray Spivey</u>	description of formations encountered	from	to
1 <u>Three Rivers</u> (mailing address)	<u>Clay</u>	0	22
WELL LOCATION: sec. <u>11</u> T. <u>6</u> N. R. <u>6</u> E	<u>mud</u>	22	110
<u>8</u> miles <u>North</u> of <u>MP</u> (distance) (direction) (nearest town)	<u>Clay</u>	110	432
WELL PURPOSE: <u>home</u> (home, irrigation, municipal, industrial)	<u>sand</u>	432	453
WELL COMPLETION DATA:			
(1) diameter (inches) <u>2</u>			
(2) total depth (feet) <u>453</u>			
(3) static water level (feet) <u>5</u> <u>below</u> top of ground. <u>above</u>			
(4) casing <u>galv</u> (material) (depth)			
(size) If telescope see back.			
(5) screen <u>10</u> (length) <u>443</u> (depth to top)			
<u>2</u> (size) <u>stainless</u> (material)			
(6) pump <u>1/2</u> (HP) <u>6</u> (yield gpm)			
<u>elec</u> (type power)			
(7) electric log <u>no</u> (yes or no)			
(organization running log)			
(8) how well bottom plugged <u>BP Valve</u>			
DRILLERS REMARKS:			


CODE

APR 21 1969

MISS. BD. OF
WATER COMM.

If well telescopes please sketch and show depths.

GROUND LEVEL

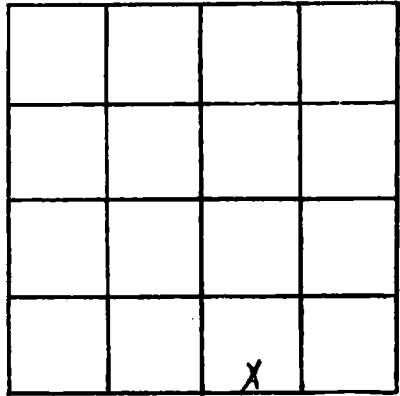

SECTION 11

Please indicate well location X.

ADDITIONAL INFORMATION

If more than one screen, show locations of each on sketch.