

Jackson  
L 76  
2-12-68

MISSISSIPPI  
BOARD OF WATER COMMISSIONERS  
416 North State Street  
Jackson, Mississippi 39201

CODED

WATER WELL DRILLERS LOG

Feb 12 1968 Colville Water Sup Jackson  
date well completed firm name county well located


LANDOWNER: <u>C.B. Scarborough</u>	description of formations encountered	from	to
<u>Rt. 3</u>			
<u>Princeton Miss</u> (mailing address)	<u>clay</u>	<u>0</u>	<u>40</u>
WELL LOCATION:	<u>sand</u>	<u>40</u>	<u>90</u>
sec. <u>2</u> T. <u>6</u> N. R. <u>6</u> E.	<u>clay</u>	<u>90</u>	<u>264</u>
<u>10</u> miles <u>North</u> of <u>MP</u>	<u>sand</u>	<u>264</u>	<u>299</u>
WELL PURPOSE: <u>home</u> (home, irrigation, municipal, industrial)			
WELL COMPLETION DATA:			
(1) diameter (inches) <u>2</u>			
(2) total depth (feet) <u>299</u>			
(3) static water level (feet) <u>104</u> <sup>below</sup> top of ground			
(4) casing <u>galv</u> (material) (depth)			
(size) if telescope see back.			
(5) screen <u>4</u> , <u>295</u> (length) (depth to top)			
<u>2</u> , <u>stainless</u> (size) (material)			
(6) pump _____ (HP) (yield gpm)			
(type power)			
(7) electric log <u>no</u> (yes or no)			
(organization running log)			
(8) how well bottom plugged <u>SPN</u>			
DRILLERS REMARKS: <u>pump installed by owner</u>			

JAN - 8 1970

MISS. Bd. of  
WATER COMMISSIONERS

If well telescopes please sketch and show depths.

GROUND LEVEL

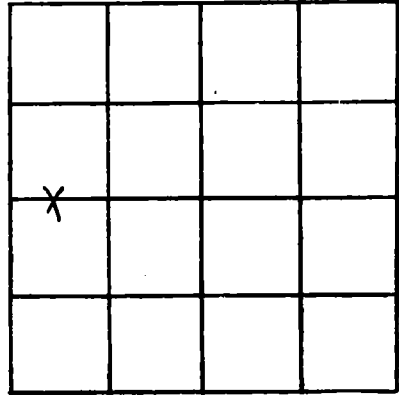

SECTION 2

Please indicate well location X.

ADDITIONAL INFORMATION

If more than one screen, show locations of each on sketch.