

Jackson
 L 80
 10-15-68

CODED

MISSISSIPPI
 BOARD OF WATER COMMISSIONERS
 416 North State Street
 Jackson, Mississippi 39201


WATER WELL DRILLERS LOG

Oct 15 1968 date well completed
 Colville Water Supply firm name
 Jackson county well located

LANDOWNER: Joe Bullock	description of formations encountered	from	to
(mailing address)	Clay	0	16
WELL LOCATION: sec. 13 T. 6 N R. 6 E 5 miles N of Brookhaven	mod	16	115
WELL PURPOSE: Home (home, irrigation, municipal, industrial)			
WELL COMPLETION DATA: (1) diameter (inches) 2" (2) total depth (feet) 115 (3) static water level (feet) 10 ^{below} top of ground (4) casing galv (material), (depth) (size) If telescope see back. (5) screen 5' 110 (length) (depth to top) 2" (size) (material) (6) pump (HP) (yield gpm) (type power) (7) electric log no (yes or no) (organization running log) (8) how well bottom plugged BP			
DRILLERS REMARKS: pump installed by owner	JAN 5 1968 MISS. BD. OF WATER COM.		

If well telescopes please sketch and show depths.

GROUND LEVEL

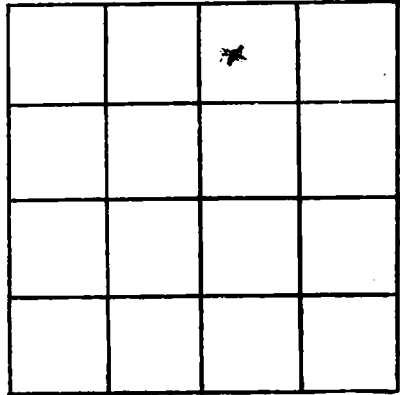

SECTION 13

Please indicate well location X.

ADDITIONAL INFORMATION

If more than one screen, show locations of each on sketch.