

Jackson
 L 81
 4-9-68

MISSISSIPPI
 BOARD OF WATER COMMISSIONERS
 416 North State Street
 Jackson, Mississippi 39201

CODED
 CODED

WATER WELL DRILLERS LOG

April 9 1968 White Water Sump Jackson
 date well completed firm name county well located


LANDOWNER: <u>City</u>	description of formations encountered	from	to
<u>Champine</u>	<u>clay</u>	<u>0</u>	<u>7</u>
<u>Call town</u> (mailing address)	<u>sand</u>	<u>7</u>	<u>146</u>
WELL LOCATION: sec. <u>43</u> T <u>6</u> N R <u>6</u> E	<u>clay</u>	<u>146</u>	<u>216</u>
<u>5</u> miles <u>north</u> of <u>MP</u> (distance) (direction) (nearest town)	<u>sand</u>	<u>216</u>	<u>264</u>
WELL PURPOSE: <u>home</u> (home, irrigation, municipal, industrial)			
WELL COMPLETION DATA: (1) diameter (inches) <u>2</u>			
(2) total depth (feet) <u>264</u>			
(3) static water level (feet) <u>18</u> ^{below} _{above} top of ground.			
(4) casing <u>plastic</u> (material) (depth)			
(size) If telescope see back.			
(5) screen <u>4'</u> <u>260</u> (length) (depth to top)			
<u>2</u> <u>stainless</u> (size) (material)			
(6) pump _____ (HP) (yield gpm)			
(type power)			
(7) electric log <u>no</u> (yes or no)			
(organization running log)			
(8) how well bottom plugged <u>BP check</u>			
DRILLERS' REMARKS: <u>old pump re-installed</u>			

JAN - 9 1970

MISS. RD. OF
 WATER COMM.

If well telescopes please sketch and show depths:

GROUND LEVEL

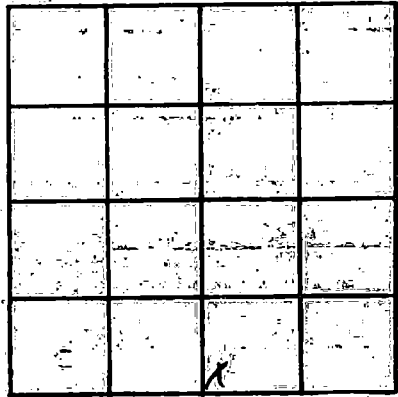

SECTION 43

Please indicate well location X.

ADDITIONAL INFORMATION

If more than one screen, show locations of each on sketch.