

Jackson
 L 83
 3-11-70

MISSISSIPPI
 BOARD OF WATER COMMISSIONERS
 416 North State Street
 Jackson, Mississippi 39201

CODED

WATER WELL DRILLERS LOG

3-11-70 date well completed 1970 Coastal Water Well Service firm name Jackson county well located

LANDOWNER: J. B. Mayo
 Rt. 2 Box 2254
 Ocean Springs, Miss.
 (mailing address)

description of formations encountered	from	to
top soil + fine sand	0	32
Blue clay	32	87
Sand-fine to med.	87	110

WELL LOCATION:
 sec. 39 T-6 R-6
 4 1/2 miles E. of Vicksburg
 (distance) (direction) (nearest town)

WELL PURPOSE: Home
 (home, irrigation, municipal, industrial)

CODED

WELL COMPLETION DATA:

(1) diameter (inches) 2"

(2) total depth (feet) 110

(3) static water level (feet) 12 below top of ground.

(4) casing galv. (material), 105' (depth)
 2" (size) If telescope see back.

(5) screen 5' (length), 105' (depth to top)
 2" (size), plastic (material)

(6) pump 1/2 (HP), 10 (yield gpm)
 Elec. (type power)

(7) electric log NO (yes or no)

(8) how well bottom plugged Back Wash Valve


DRILLERS REMARKS:

MAR 17 1970

MISS. BD. OF WATER COMMISSIONERS

If well telescopes please sketch and show depths.

GROUND LEVEL

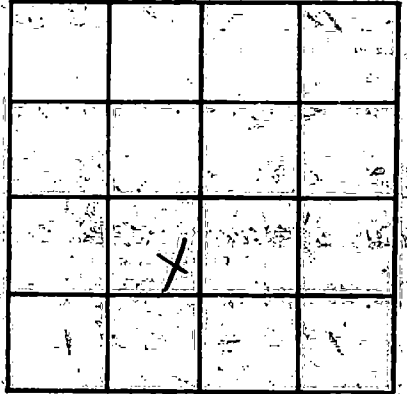

SECTION 39

Please indicate well location: X.

ADDITIONAL INFORMATION

If more than one screen, show locations of each on sketch.