

Jackson
L 84
5-26-70

MISSISSIPPI
BOARD OF WATER COMMISSIONERS
416 North State Street
Jackson, Mississippi 39201

CODED

WATER WELL DRILLERS LOG

5-26-70 date well completed 1970 M+H Well Co. firm name Jackson County well located

LANDOWNER: Rev. Robert Parker

Pascagoula, Miss
(mailing address)

WELL LOCATION:
sec. 2 T. 6 N R. 6 E
4 miles S of ~~Meridian~~ ^{Stennis}
(distance) (direction) (nearest town)

WELL PURPOSE: Church
(home, irrigation, municipal, industrial)

WELL COMPLETION DATA:

- (1) diameter (inches) 2"
- (2) total depth (feet) 294
- (3) static water level (feet) 137 ^{below} _{above} top of ground.
- (4) casing Plastic, 284, (material) (depth)
- _____ if telescope see back.
(size)
- (5) screen 10T, 284 (length) (depth to top)
2", Plastic (size) (material)
- (6) pump 1 (HP) 12 (yield gpm)
Electric (type power)
- (7) electric log No (yes or no)
- _____ (organization running log)
- (8) how well bottom plugged Back wash valve

description of formations encountered	from	to
Dirt	0	2
Red Dirt	2	8
White Clay	8	15
Black Clay	15	17
White Clay	17	23
Sand	23	29
Blue Clay	29	43
Blue Clay Brown	43	93
Speckled	93	250
Silk Sand	250	264
Course Sand	264	275
	275	294

CODED


JUN 15 1970

DRILLERS REMARKS:

MISS. Bd. OF
WATER COMM.

If well telescopes please
sketch and show depths.

GROUND LEVEL

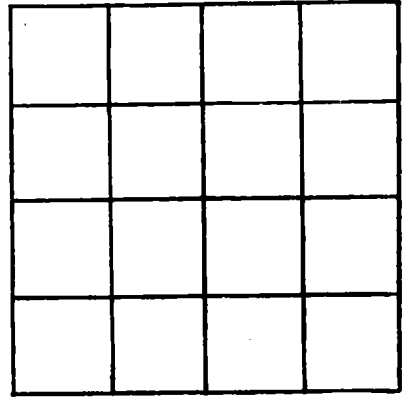

SECTION _____

Please indicate well location X.

ADDITIONAL INFORMATION

If more than one screen,
show locations of each on sketch.