

Jackson
L 85
7-2-70

MISSISSIPPI
BOARD OF WATER COMMISSIONERS
416 North State Street
Jackson, Mississippi 39201

CODED

WATER WELL DRILLERS LOG

July 2, 1970 data well completed
Cobble Water Supply firm name
Jackson county well located

LANDOWNER	description of formations encountered	from	to
Billy Mathews	clay	0	48
Wilson Springs (mailing address)	sand & gravel	48	69
	clay	69	95
	hard	95	142
	clay	142	225
	sand	225	240

WELL LOCATION:
sec. 24 T. 8 N. R. 6 E.
8 miles N of M.P.
(distance) (direction) (nearest town)

WELL PURPOSE: home
(home, irrigation, municipal, industrial)

WELL COMPLETION DATA:

(1) diameter (inches) 2

(2) total depth (feet) 240

(3) static water level (feet) 12 ^{below} above top of ground.

(4) casing galv. 235 (material) (depth)

(size) if telescope see back.

(5) screen 5' 235 (length) (depth to top)

2 stamlok (size) (material)

(6) pump (HP) (yield gpm)

(type power)

(7) electric log no (yes or no)

(organization running log)

(8) how well bottom plugged B.P. Vahy

CODED


JUL 27 1970

DRILLERS REMARKS: pump installed by owner

MISS. BD. OF
WATER COMM.

If well telescopes please sketch and show depths.

GROUND LEVEL

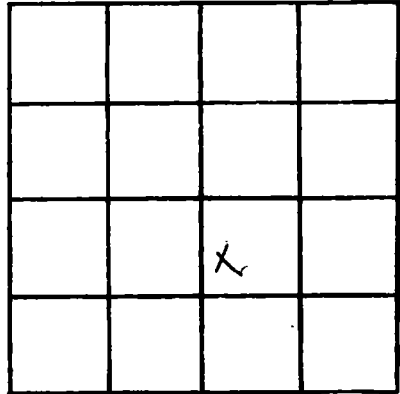

SECTION 24

Please indicate well location X.

ADDITIONAL INFORMATION

If more than one screen, show locations of each on sketch.