

JACKSON
 L 86
 7-15-70

MISSISSIPPI
 BOARD OF WATER COMMISSIONERS
 416 North State Street
 Jackson, Mississippi 39201

CODED

WATER WELL DRILLERS LOG

July 15 1970 Cobble Water Supply Jackson
 date well completed firm name county well located

LANDOWNER: Harry Self Jr.
Coll Town
 (mailing address)

WELL LOCATION:
 sec. 25 T-6 N R-6 E
7 1/2 miles North of MP
 (distance) (direction) (nearest town)

WELL PURPOSE: home
 (home, irrigation, municipal, industrial)

WELL COMPLETION DATA:
 (1) diameter (inches) 2
 (2) total depth (feet) 219
 (3) static water level (feet) 8 1/2 ^{below} above top of ground.
 (4) casing galv 214
 (material) (depth)
 (size) if telescope see back.
 (5) screen 5' 214
 (length) (depth to top)
2 Stainless
 (size) (material)
 (6) pump _____ (HP) _____ (yield gpm)
 (type power) _____
 (7) electric log no
 (yes or no)
 (organization running log) _____
 (8) how well bottom plugged BP Valay

description of formations encountered	from	to
Clay	0	8
sand	8	68
clay	68	100
sand	100	131
clay	131	205
sand	205	219

made well at 130' - failed to clear up


CODED

AUG 17 1970

DRILLERS REMARKS: pump installed by owner

If well telescopes please sketch and show depths.

GROUND LEVEL

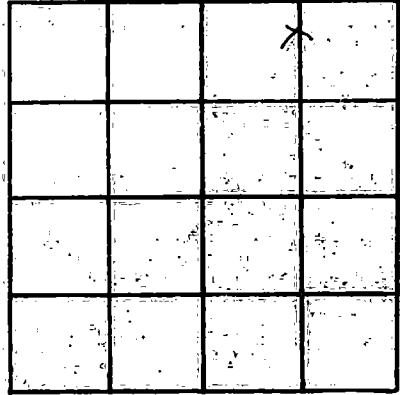

SECTION 25

Please indicate well location X.

ADDITIONAL INFORMATION

If more than one screen, show locations of each on sketch.