

JACKSON

DL 89

8-8-62

WATER WELL DRILLERS LOG

CODED

3566

Date: Aug 8, 1962, Driller: Flem. Colville County Jackson

(Name)

(1) Owner of Land: James E. Howard
(Name)

Description & Color of Materials
Sand, Clay, Red Clay, Shell, etc.

Thick-
ness
Feet

Depth
Feet

East Louisiana Mine
(Address)

0-21 clay
21-40 soft clay
40-42 sand

(2) Location: Irregular Sect 3566
1/4, Sec. T R

42-63 Sand & Gravel
63-79 Sand & Gravel
79-84 Britty clay

5 miles north, of Wm. Davis
(distance) (direction) (Nearest Town)

81-105 streaks
105-126 streaks
126-147 streaks

(3) Topography: Flat
(Hilly) (Flat) (Level)

147-168 Hard clay
168-189 clay
189-210 clay

(4) Purpose of Well: Domestic
(Domestic Irrigation
Municipal, Industrial, Other)

210-230 clay
230-231 sand
231-235 streaks
235-250 sand

Information upon completion of well:

(1) Diameter 1 1/4 inches.

(2) Total Depth 250 feet.

(3) Water Level 6'4" feet below top of ground.

(4) Cased to _____, Size _____

(5) Screen: Size 1/4", Length 10'

(6) Were any formations sealed against pollution?


_____ yes, X no.

If YES depth of formation _____

Why _____

Drillers Remarks: _____

CODED

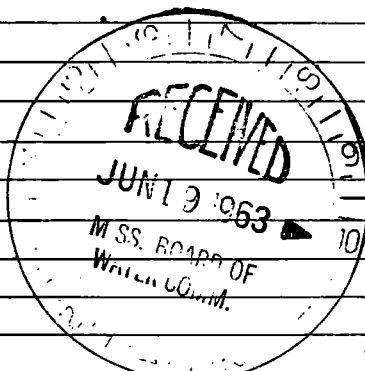

Well No. 165

(Use Back Side)

