

JACKSON

MISSISSIPPI BOARD OF WATER COMMISSIONERS

DL 90

668 3567
WATER WELL DRILLERS LOG

CODED

8-9-62

Date: Aug 9, 1962, Driller John Clibbe County Jackson

(Name)

(1) Owner of Land: R. B. Smith
(Name)

Locust Grove Mine
(Address)

(2) Location: 2 1/2 miles W of 35 6 6
1/4, Sec. 35 T. 6 R. 6

(3) Topography: Flat
(Hilly) (Flat) (Level)

(4) Purpose of Well: Domestic
(Domestic Irrigation
Municipal, Industrial, Other)

Description & Color of Materials
Sand, Clay, Red Clay, Shell, etc.

Thick-
ness
Feet

Depth
Feet

0-20 clay
20-40 clay
40-60 sand
60-80 sand
80-90 sand
90-100 clay
100-120 streaks
120-140 streaks
140-160 streaks
160-170 sand
170-180 clay
180-200 clay
200-220 clay
220-227 clay
227-234 sand
234-240 clay
240-255 sand
TD

Information upon completion of well:

(1) Diameter: 1 1/4 inches.

(2) Total Depth: 255 feet.

(3) Water Level: 6'6" feet below top of ground.

(4) Cased to _____, Size _____

(5) Screen: Size 1 1/4; Length 10'

(6) Were any formations sealed against pollution?


_____ yes, X no.

If YES depth of formation _____

Why _____

Drillers Remarks: _____

CODED

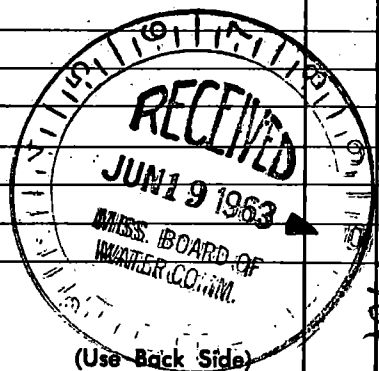

Well No. 166

