

JACKSON  
L 91  
6-12-71

MISSISSIPPI  
BOARD OF WATER COMMISSIONERS  
416 North State Street  
Jackson, Mississippi 39201

**CODED**

WATER WELL DRILLERS LOG

June 12 1971 date well completed  
Cobille Water Supply firm name  
Jackson county well located

LANDOWNER: Gene Browning  
Wolf Ridge, Miss.  
(mailing address)

description of formations encountered	from	to
clay	0	17
sand & gravel	17	91
clay	91	133
sand	133	176

WELL LOCATION:  
sec. 1 T. 6 N. R. 6 E.  
11 miles North of M.P.  
(distance) (direction) (nearest town)

WELL PURPOSE: Home  
(home, irrigation, municipal, industrial)

WELL COMPLETION DATA:

(1) diameter (inches) 2

(2) total depth (feet) 171

(3) static water level (feet) 15'-11" below top of ground.

(4) casing galv. 171 (material) (depth)  
(size) if telescope see back.

(5) screen 5' 171 (length) (depth to top)  
2" standars (size) (material)

(6) pump (HP) (yield gpm)  
(type power)

(7) electric log no (yes or no)  
(organization running log)

(8) how well bottom plugged BP plug

**CODED**


JUL 10 1971

MISS. BD. OF  
WATER

DRILLERS REMARKS: pump installed by owner

If well telescopes please sketch and show depths.

GROUND LEVEL

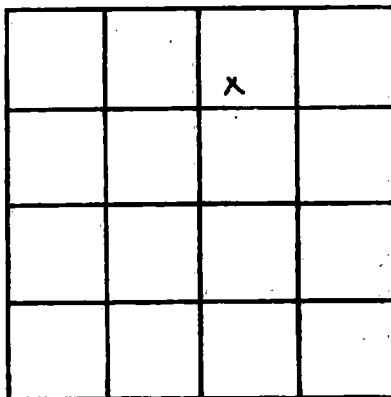

SECTION 1

Please indicate well location X.

ADDITIONAL INFORMATION

If more than one screen, show locations of each on sketch.