

JACKSON
 L. 94
 3-3-72

MISSISSIPPI
 BOARD OF WATER COMMISSIONERS
 416 North State Street
 Jackson, Mississippi 39201

CODED

WATER WELL DRILLERS LOG

MARCH 3 1972 data well completed
 Colville Water Supply firm name
 Jackson county well located

LANDOWNER: <u>Raymond Eriverson</u>	description of formations encountered	from	to
Wilson Springs MISS. (mailing address)	Old hole clay sand	164 164 330	330 362
WELL LOCATION: sec. <u>26</u> T. <u>6</u> N. R. <u>6</u> E. <u>8</u> miles <u>North</u> of <u>M.P.</u> (distance) (direction) (nearest town)			
WELL PURPOSE: <u>home</u> (home, irrigation, municipal, industrial)			
WELL COMPLETION DATA: (1) diameter (inches) <u>2</u> (2) total depth (feet) <u>362</u> (3) static water level (feet) <u>10</u> ^{below} _{above} top of ground. (4) casing <u>galv</u> <u>357</u> (material) (depth) (size) If telescope see back. (5) screen <u>5'</u> <u>357</u> (length) (depth to top) <u>2</u> <u>Stainless</u> (size) (material) (6) pump <u>1/2</u> <u>10</u> (HP) (yield gpm) <u>elc</u> (type power) (7) electric log <u>no</u> (yes or no) (organization running log) (8) how well bottom plugged <u>B.P. Value</u>			
DRILLERS REMARKS:			


CODED

MAY 24 1972

MISS. BD. OF
 WATER COMM.

If well telescopes please sketch and show depths.

GROUND LEVEL

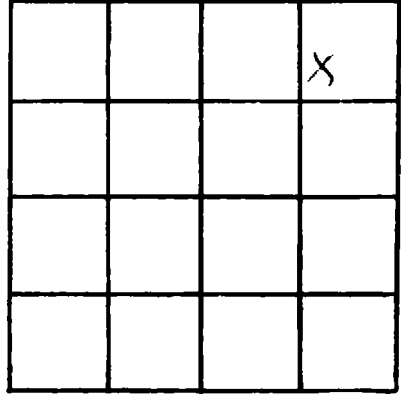

SECTION 26

Please indicate well location X.

ADDITIONAL INFORMATION

If more than one screen, show locations of each on sketch.