

JACKSON  
L 98  
4-13-72

MISSISSIPPI  
BOARD OF WATER COMMISSIONERS  
416 North State Street  
Jackson, Mississippi 39201

WATER WELL DRILLERS LOG **CODED**

April 13 1972 Colville Water Sup Jackson  
date well completed firm name county well located

LANDOWNER: Cecil  
Fulton  
Wolf Ridge  
(mailing address)

description of formations encountered	from	to
Clay	0	16
SAND and gravel	16	69
clay	69	80
Sand	80	111

WELL LOCATION:  
sec. 13 T-6 N R-6 E  
9 miles North of MP  
(distance) (direction) (nearest town)

WELL PURPOSE: none  
(home, irrigation, municipal, industrial)

- WELL COMPLETION DATA:
- (1) diameter (inches) 2
  - (2) total depth (feet) ~~111~~ 111
  - (3) static water level (feet) 10 below top of ground.
  - (4) casing galv. 106  
(material) (depth)
  - (size) if telescope see back.
  - (5) screen 5 106  
(length) (depth to top)
  - 2" stainless  
(size) (material)
  - (6) pump 1 10  
(HP) (yield gpm)
  - elec  
(type power)
  - (7) electric log No  
(yes or no)
  - (organization running log)
  - (8) how well bottom plugged BP value

**CODED**


MAY 24 1972

MISS. Bd. OF  
WATER COMM

DRILLERS REMARKS:

If well telescopes please sketch and show depths.

GROUND LEVEL

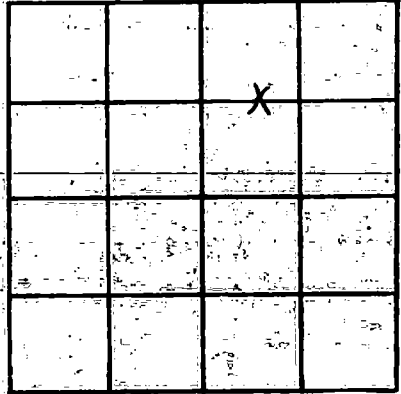

SECTION 13

Please indicate well location X:

ADDITIONAL INFORMATION

If more than one screen, show locations of each on sketch.