

JACKSON
L 103
3-23-73

MISSISSIPPI
BOARD OF WATER COMMISSIONERS
416 North State Street
Jackson, Mississippi 39201

CODED

WATER WELL DRILLERS LOG

COAST WATER WELL SERVICE

Jackson
county well located

3/23 1973
date well completed

firm name

LANDOWNER: Oscar Thomas
P.O. Box 2126
Ocean Springs, Ms.
(mailing address)

description of formations encountered

from to

| | | |
|----------------------------|-----------|-----------|
| <u>top soil</u> | <u>0</u> | <u>15</u> |
| <u>fine to coarse sand</u> | <u>15</u> | <u>65</u> |

WELL LOCATION:

sec. 7 T. 6 N. R. 6 E
S W
4 miles East of Harlem
(distance) (direction) (nearest town)

| | | |
|--------------------------|------------|------------|
| <u>blue clay</u> | <u>65</u> | <u>320</u> |
| <u>fine to med. sand</u> | <u>320</u> | <u>360</u> |

WELL PURPOSE: home
(home, irrigation, municipal, industrial)

WELL COMPLETION DATA:

- (1) diameter (inches) 2"
- (2) total depth (feet) 360'
- (3) static water level (feet) 55' below top of ground
- (4) casing P.V.C. (350' depth)
- 2" (size) if telescope see back.
- (5) screen 10' (350' depth to top)
- 2" (P.V.C. material)
- (6) pump 1 (10 yield gpm)
- elec. (type power)
- (7) electric log NO (yes or no)

CODED

(organization running log)

(8) how well bottom plugged B.W.
Value


JUN 25 1973

DRILLERS REMARKS:

If well telescopes please sketch and show depths.

GROUND LEVEL

WELL SERVICE

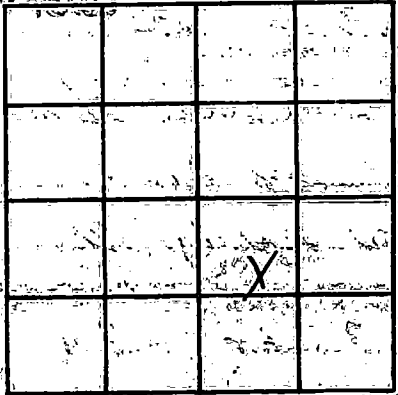

SECTION 7

Please indicate well location X.

ADDITIONAL INFORMATION

If more than one screen, show locations of each on sketch.