

JACKSON
L 107
10-2-73

MISSISSIPPI
BOARD OF WATER COMMISSIONERS
416 North State Street
Jackson, Mississippi 39201

CODED

WATER WELL DRILLERS LOG

Oct 2 1973 Central Water Supply Jackson
date well completed firm name county well located

LANDOWNER: Robertson
Roberts
Helena Miss
(mailing address)

description of formations encountered	from	to
Clay	0	15
sand	15	27
clay	27	116
sand	116	146
clay	146	230
sand	230	263

WELL LOCATION:
sec. 24 T. 6 N R. 6 E
7 1/2 miles North of M.P.
(distance) (direction) (nearest town)

WELL PURPOSE: home
(home, irrigation, municipal, industrial)

CODED

WELL COMPLETION DATA:

(1) diameter (inches) 2

(2) total depth (feet) 263

(3) static water level (feet) 30 ^{below}/_{above} top of ground.

(4) casing galv 253
(material) (depth)
(size) if telescope see back.

(5) screen 10 253
(length) (depth to top)
2 standards
(size) (material)

(6) pump 1 1/2 20
(HP) (yield gpm)
elec
(type power)

(7) electric log no
(yes or no)
(organization running log)


(8) how well bottom plugged B.P. Valve

DRILLERS REMARKS:

APPROVED

If well telescopes please sketch and show depths.

GROUND LEVEL

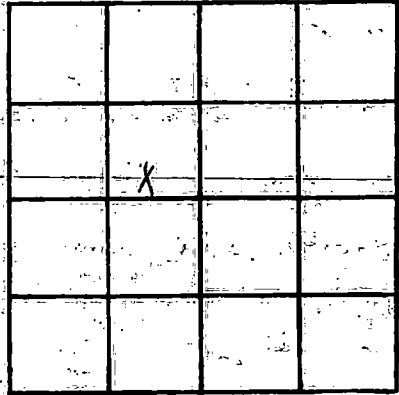

SECTION 24

Please indicate well location X.

ADDITIONAL INFORMATION

If more than one screen, show locations of each on sketch.