

L 112
 Jackson
 6/15/74

MISSISSIPPI
 BOARD OF WATER COMMISSIONERS
 416 North State Street
 Jackson, Mississippi 39201

CODED

WATER WELL DRILLERS LOG

June 15 1974 nd Corbelle Water Supply Jackson
 date well completed firm name county well located

LANDOWNER: Harold Young
Escatawpa, Ms.
 (mailing address)

description of formations encountered	from	to
<u>pipe clay</u>	<u>0</u>	<u>15</u>
<u>sand</u>	<u>15</u>	<u>20</u>
<u>clay</u>	<u>20</u>	<u>23</u>
<u>sand</u>	<u>23</u>	<u>24.5</u>

WELL LOCATION:
 sec. 35 T. 6 N. R. 6 E
6 miles North of MS
 (distance) (direction) (nearest town)

WELL PURPOSE: Domestic
 (home, irrigation, municipal, industrial)

- WELL COMPLETION DATA:
- diameter (inches) 2
 - total depth (feet) 245
 - static water level (feet) 30 ^{below} _{above} top of ground.
 - casing plastic 240
 (material) (depth)
 (size) if telescope see back.
 - screen 5' 240
 (length) (depth to top)
2" plastic
 (size) (material)
 - pump 1/2 17
 (HP) (yield gpm)
elec
 (type power)
 - electric log no
 (yes or no)
 - (organization running log)
 - how well bottom plugged BRW


DRILLERS REMARKS:

RECEIVED
 JUN 5 1975

MISS. BD. OF WATER COMMISSIONERS

If well telescopes please sketch and show depths.

GROUND LEVEL

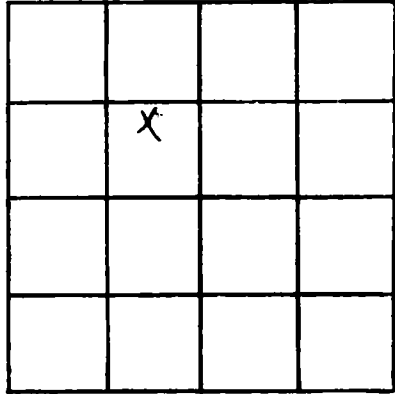

SECTION 35

Please indicate well location X.

ADDITIONAL INFORMATION

If more than one screen, show locations of each on sketch.