

Jackson  
 L 115  
 12/1/74

MISSISSIPPI  
 BOARD OF WATER COMMISSIONERS  
 416 North State Street  
 Jackson, Mississippi 39201

1302

WATER WELL DRILLERS LOG

12/1 1974 COAST WATER WELL SERVICE Jackson  
 date well completed firm name county well located

LANDOWNER: John Ledbetter  
 4020 Laurel Rd.  
 Pascagoula Ms.  
 (mailing address)

description of formations encountered	from	to
top soil	0	21
coarse sand + gravel	21	90
Blue Clay	90	145
coarse sand	145	190

WELL LOCATION:  
 sec. 1 T. 6 S. R. 6 W.  
 8 miles N of Escatawpa  
 (distance) (direction) (nearest town)

WELL PURPOSE: Home  
 (home, irrigation, municipal, industrial)

WELL COMPLETION DATA:  
 (1) diameter (inches) 2"  
 (2) total depth (feet) 190  
 (3) static water level (feet) 40 below top of ground.  
 (4) casing PVC, 180' (material) (depth)  
 2" (size) if telescope see back.  
 (5) screen 10' 180' (length) (depth to top)  
 2" PVC (size) (material)  
 (6) pump 1 8 (HP) (yield gpm)  
 elec. (type power)  
 (7) electric log NO (yes or no)  
 (organization running log)  
 (8) how well bottom plugged B. W. V.


MISSISSIPPI BOARD OF WATER COMMISSIONERS  
 OCT 22 1975

DRILLERS REMARKS:

MISS. BD. OF WATER COMM

If well telescopes please sketch and show depths.

GROUND LEVEL

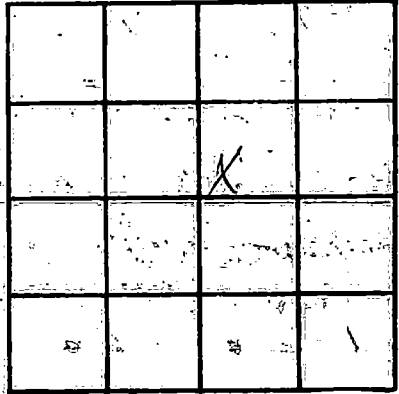

SECTION 1

Please indicate well location X.

ADDITIONAL INFORMATION

If more than one screen, show locations of each on sketch.