

Jackson
L 118

MISSISSIPPI
BOARD OF WATER COMMISSIONERS
416 North State Street
Jackson, Mississippi 39201

CODED

WATER WELL DRILLERS LOG

8-19-80

8-19-80

date well completed

Coast Water Well Service

firm name

Jackson

county/well located

LANDOWNER: Austin Roberts

description of formations encountered

from

to

P.O. Box 441

Top Soil

0

3

Escatawpa, Miss.

(mailing address)

39152

Red Coarse Sand + Gravel

3

40

WELL LOCATION:

sec. 25 T. 6 S. R. 6 W. of ESCATAWPA
4 miles (distance) N (direction) (nearest town)

Blue Clay

40

278

Gray Coarse Sand

278

321

WELL PURPOSE: home
(home, irrigation, municipal, industrial)

WELL COMPLETION DATA:

- (1) diameter (inches) 2"
- (2) total depth (feet) 321'
- (3) static water level (feet) 50' below top of ground.
- (4) casing PVC (material) 311' (depth)
2" (size) if telescope see back.
- (5) screen 10' (length) 311' (depth to top)
2" (size) PVC (material)
- (6) pump 1 HP (HP) 8 (yield gpm)
1/2 HP (type power)
- (7) electric log No (yes or no)

(organization running log)

(8) how well bottom plugged
Pachinal valve

DRILLERS REMARKS:


DEPT. OF NATURAL RESOURCES
BUREAU OF LAND & WATER RESOURCES

APR - 7 1980

RECEIVED

If well telescopes please sketch and show depths.

GROUND LEVEL

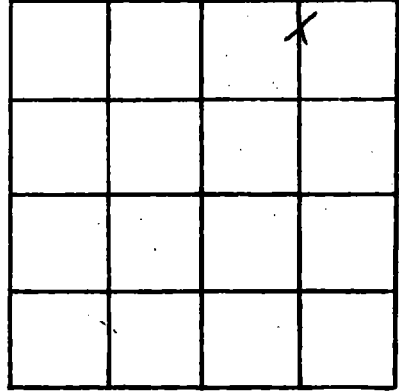

SECTION 25

Please indicate well location X.

ADDITIONAL INFORMATION

If more than one screen,
show locations of each on sketch.