

MISSISSIPPI DEPARTMENT OF NATURAL RESOURCES

Bureau of Land and Water Resources

Southport Mall

P.O. Box 10631

CODED

Jackson, Mississippi 39209

WATER WELL DRILLERS LOG

Jackson
L122

10-15-82 date well completed
Coast Water Well Sew. firm name
Jackson county well located

LANDOWNER: Buddu Levey
The Well Co.
Particular
Van Cleve, Miss.
(mailing address)

description of formations encountered	from	to
Top soil	0	10'
Red fine sand	10'	23'
Red Clay	23'	48'
Blue Clay	48'	86'
Red Course sand	86'	128'
Blue Clay	128'	370'
Blue Clay & Shale sand	370'	418'
gray Course sand	418'	443'

WELL LOCATION:
sec. 39 T 6 N R 6 E
S W
4 miles ESE of VAN CLEAVE
(distance) (direction) (nearest town)

WELL PURPOSE: none
(home, irrigation, municipal, industrial)

- WELL COMPLETION DATA:
- (1) diameter (inches) 4 x 2"
 - (2) total depth (feet) 443'
 - (3) static water level (feet) 31' below top of ground
 - (4) casing PVC, 423' (material), (depth)
4 x 2" (size) if telescope see back.
 - (5) screen 20' (length), 423' (depth to top)
4 x 2" (size), (material)
 - (6) pump 1 hp. 27 (HP), (yield gpm)
Elect. (type power)
 - (7) electric log No. (yes or no)
- (organization running log)

(8) how well bottom plugged
Back wash valve

DRILLERS REMARKS:


DEPT. OF NATURAL RESOURCES
BUREAU OF LAND & WATER RESOURCES

NOV 18 1982

RECEIVED

If well telescopes please sketch and show depths:

GROUND LEVEL

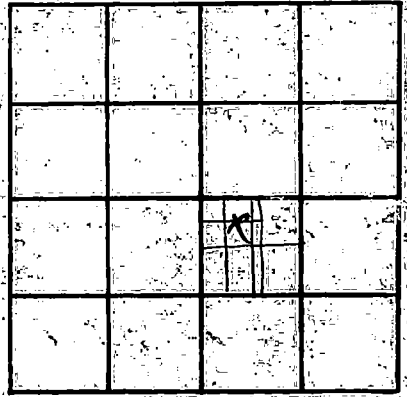

SECTION 39

Please indicate well location 'X':

ADDITIONAL INFORMATION

If more than one screen, show locations of each on sketch: