

**MISSISSIPPI DEPARTMENT OF ENVIRONMENTAL QUALITY**  
Bureau of Land and Water Resources

P. O. Box 10631  
Jackson, MS 39289-0631  
**WATER WELL DRILLERS LOG**

COUNTY WELL LOCATED <i>Jackson</i>	WELL NUMBER <i>L135</i>	CODED <input checked="" type="checkbox"/>
DATE WELL COMPLETED <i>7-28-92</i>		

PERMIT NUMBER
NAME OF DRILLING FIRM <i>Coast Water Well Drillers Inc</i>

NAME & MAILING ADDRESS OF LANDOWNER <i>A. S. Coleman</i>			
WELL LOCATION: SEC <u>1</u> TOWNSHIP <u>6</u> RANGE <u>6</u>			
DISTANCE <u>7</u> Miles DIRECTION <u>South</u> of NEAREST TOWN <u>Wade</u>			
OTHER LANDMARK			
WELL PURPOSE: <u>Home Irrigation</u> , Municipal, Industrial, Fish Pond, etc.			

<b>PUMP DATA</b>		
PUMP TYPE (Circle One): Submersible, Turbine, <u>Jet</u> Flowing Well, Other (Describe) _____		
POWER TYPE (Circle One): <u>Electric</u> , Tractor, Diesel, Gasoline, Butane, Other (Describe) _____ H/P <u>1</u>		
Pump Capacity (GPM) <u>8</u>	No. of Stages	Setting Depth <u>      </u> FT.
PUMP TEST: Well yielded _____ GPM with a drawdown of _____ ft. after _____ hours of pumping		

<b>WELL DATA</b>		
Well Depth <u>301</u>	Casing Diameter (In.) <u>2</u>	Casing Length (Ft.) <u>287</u>
Type of Casing <u>PVC</u>	Hole Depth <u>301'</u>	Depth to Static Water Level <u>48'</u>
TYPE OF COMPLETION: (Circle One or More): <u>Natural Development</u> , Underreamed, Telescoped, Open Hole, Other (Describe) _____		
Top of Lap Pipe or Reduction in Casing <u>      </u> FEET		
IF TELESCOPED OR MORE THAN ONE SCREEN: USE BACK PAGE		

<b>LOG DATA</b>	
TYPE OF LOG RUN (Circle One): Electric, Gamma Ray, Density, <u>No Log Run</u> , Other (Describe) _____	
Name of Organization Running Log	

<b>SCREEN DATA</b>		
Diameter - Inches <u>2</u>	Length - Feet <u>10'</u>	Slot Size - Inches <u>.008</u>
Screen Type <u>PVC</u>	Depth to Bottom - Feet <u>297'</u>	

<b>GEOLOGIC DATA (Office Use Only)</b>			
Surface Elev.	Geologic Unit	Unit Thickness	Depth to Top
Subs. SWL	Date	Analysis	Aquifer Test
Driller's Remarks			

DESCRIPTION OF FORMATIONS ENCOUNTERED	FROM	TO	FORMATIONS (Continued)	FROM	TO
<i>Top soil</i>	<i>0</i>	<i>2</i>			
<i>Gray Clay</i>	<i>2</i>	<i>12</i>			
<i>Coarse sand/gravel</i>	<i>12</i>	<i>90</i>			
<i>Five Days of Aquifer</i>	<i>90</i>	<i>255</i>			
<i>Coarse sand</i>	<i>255</i>	<i>301</i>			

**RECEIVED**


OCT 07 1992

Dept. of Environmental Quality  
Bureau of Land & Water Resources

IF MORE SPACE IS NEEDED, USE BACK

If well telescopes please sketch and show depths.

GROUND LEVEL

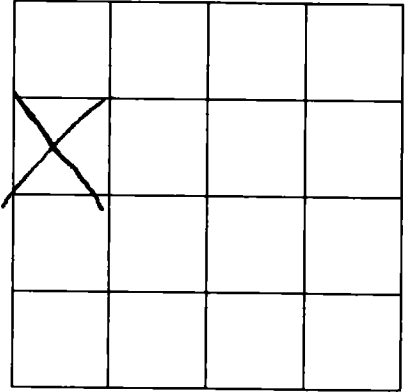

SECTION \_\_\_\_\_

Please indicate well location X.

ADDITIONAL INFORMATION

If more than one screen,  
show location of each on sketch.