
	State Well Report	For Office Use Only:		
County: Oukson Missing	Part 1			
Mississ	ippi Department of Environmental Qu	nality Aquifer:		
1 	Office of Land and Water Resources P.O. Box 10631	Well#: 1-168		
Driller: Coast Water Well	Jackson, MS 39289-0631	L. S. Elevation:		
Date drilling completed: 12-9-04	(601)961-5210	1		
	(601)354-6938 (fax)	E-log #:		
State Law requires that this report be p 30 days of completion of drilling of the	repared by the driller in detail and well.			
Well Owner Information		Well Location		
Owner Name Billy Matthews	Latitude:30 • 30	, 139 " Longitude: 088° 33 '071"		
Mailing Address: 11018 Hwy 613	Method of Lat/Long (circle one): Conventional Survey,		
	USGS quad, Ha	nd-held GPS) Survey-grade GPS		
MossPoint Ms 3	756 8 56 4 se	c 23 Twn T65 Rng R6 W		
City State	Zip Code Distance Dire	ection Nearest Town 234 of Muss Point		
Telephone No. (208) 475-6770_	$4'/2$ Miles N_b	est of Moss Point		
	Well Data			
Purpose of Well (circle one) Home Industrial	Public Supply Irrigation Fish Cui	lture Other:		
Date well drilling started: 12-9-04	Date well drilling completed:	12-9-04		
If flowing, method of flow regulation: Valve N A Other (describe)				
Static Water Level: 45 feet above or below (circle one) land surface Date measured: 12-9-04				
Method of Measurement (circle one) steel tape				
Hole depth: <u>272</u> Well depth:	272 Well grouted to a dep	pth of <u>10</u> feet DEC 3 0 20		
Type of grout (circle one): Cement Bento	onite Mix	BY: OLW		
Casing length: 262 feet Casing diame	ter:inches Type of ca	asing: <u>PVC</u>		
Screen length: 10 feet Screen diame	eter:inches Type of so	reen: PVC		
Screen slot size:inches Setti	ng depth: From <u>262</u> feet to	272 feet		
Type of completion (circle all applicable): Grave	packed Underreamed Telescoped	Open hole Natural Development		
Other	(describe):			
Top of lap pipe or reduction in casing:	feet. If telescoped or more than	one screen, describe on back of page		
Logs run (circle all applicable): No log run Elect	ric Gamma Ray Density Sonic Ne	utron Other:		
Name of organization running log(s):		Night Andrews		
I certify that the well was drilled, constructed, and completed in accordance with all applicable requirements of the Mississippi Denoting the first incompanies of the Mississippi The state of the Mississippi The				
Department of Environmental Quality and/or the Mississippi Department of Health regulations and state laws.				
JackRidadell 0-472		seh flikdell		
Print Name of Water Well Contractor and License	No. Sign	nature of Water Well Contractor		

If well telescopes please sketch below and show depths.		59	59		
Ground Level	1168	Description of Fortimetral	From	То	
		TOPSOIL		a	
		Orange clay	a	18	
		WhiteCoarse Sard	18	130	
		Blueclay	130	250	
		Graylow Medium + Medium Sand	250	278	
			ļ		
			<u> </u>		
			ļ		
			<u> </u>		
			Ļ	ļ	
					
			<u> </u>	 	
			 	 	
•			 		
			 		
			 	 	
			 		
			-	 	
			 		
			 	 	
			 		

If more than one screen, show location of each on sketch

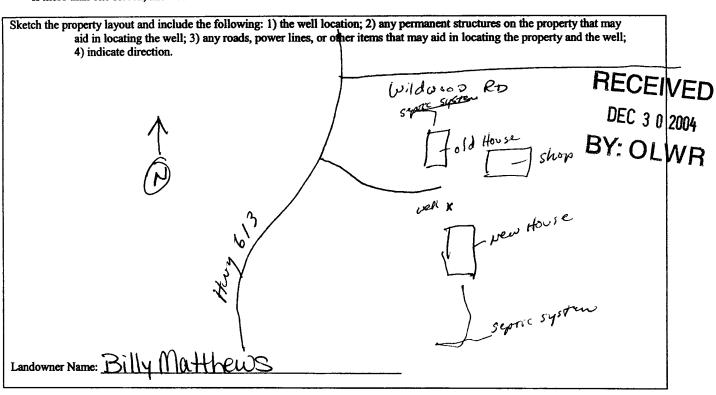

Signature of Water Well Contractor

STATE WELL REPORT

Part 2

County: Ickson Pump Installer's Completion Report
Mississippi Department of Environmental Quality
Office of Land and Water Resources Permit #: P.O. Box 10631

Jackson, MS 39289-0631 (601)961-5210 (601)354-6938 (fax)

For Office Use Only:		
Aquifer:		
Well #:	L-168	
Elevation	:	

Date completed: 13-9-04	,	1)961-5210 354-6938 (fax) Elevation:			
This report should be prepared by the pump installer in detail and filed with the Department within 30 days of the					
installation of pump. Well Owner Information		Well Location			
Owner Name: Billy Mattho		Latitude: 30°30′129″ Longitude: 088°33′071″			
Mailing Address: 11018 Hwy (813	3	Method of Lat/Long (circle one): Conventional Survey,			
		USGS quad, Hand-held GPS, Survey-grade GPS			
MossPoint Ms 39502 City State Zip Code		SW 1/4 SE 1/4 Sec 23 Twn 765 Rng R6W			
City State	zap code	Distance Direction Nearest Town			
Telephone No. 008 475-6770		4/2 Miles Norght of MESSPOINT			
Pump Type		Power Type			
Circle one		Circle one			
Air Lift (Jet)	Submersible	Diesel Engine Gasoline Engine Natural Gas			
Bucket Piston	Turbine	Electric Motor Hand Tractor PTO			
Centrifugal Rotary	Flowing Well	Windmill Other (specify):			
Other (specify):		Horse Power Rating of Motor: / HP RECEIVE			
Date Pump Installed: 12-10-04		Setting Donth: GOET USA MAR feet			
Rated Pump Capacity: 7,5	Gallons Per Minute	Number of Stages: 2 BY: OLW			
Pump Test Data	,	Method of Measuring Water Level Circle one			
Date Well Tested: 12 - 10 - 0 9	<u> </u>	Air Line Electric Measuring Line Steel Tape			
Static Water Level (A): 45 Feet	Below Land Surface	Other (specify):			
Pumping Water Level (B):Feet :	Below Land Surface	Olice (specialy).			
Drawdown [(B) - (A)]:Feet	Below Land Surface	For flowing well, measured shut in head:feet			
Test Pumping Rate: 7.5	Gallons Per Minute	Well yielded			
Duration of Pump Test (minimum 4 hours):	hours	feet afterhours of pumping			
I HEREBY CERTIFY that the above staten	nents are true to the best	t of my knowledge.			

I HEREBY CERTIFY that the above statements are true to the best of	my knowledge.	
John Elkins 0-716P	bli (le	
Print Name of Pump Installer and License No. (if applicable)	Signature of Pump Installer	