

# State Well Report

## Part 1 - Driller's Log

Mississippi Department of Environmental Quality  
Office of Land and Water Resources  
P.O. Box 2309  
Jackson, MS 39225  
(601)961- 5210  
(601)961- 5228 (fax)

### For Office Use Only:

Aquifer: \_\_\_\_\_  
Well #: L 0213  
L. S. Elevation: \_\_\_\_\_  
E-log #: \_\_\_\_\_

County: Jackson 17302  
Permit #: MS-6W-47384  
Driller: Hyman Well  
Date drilling completed: 2-29-2019

**State Law requires that this report be prepared by the license holder responsible for the work and filed with the Department at the above address within 30 days of completion of drilling of the well or borehole.**

| Information on Well Owner<br>(Landowner if borehole is not for a water well) | Well or Borehole Location   |
|--|---|
| Owner Name: <u>Jackson County Utility Authority</u>                          | Latitude: <u>30° 31' 46" 46.71</u> Longitude: <u>88° 32' 34" 34.29</u><br><u>30.529642</u> <u>88.542806</u> |
| Mailing Address: <u>1225 Jackson Avenue</u>                                  | Method of Lat/Long (circle one): <u>Conventional Survey</u> , <u>858</u>                                    |
| <u>Pascagoula MS 39567</u>   | USGS quad, Hand-held GPS, Survey-grade GPS<br><u>NE 1/4 NW 1/4 Sec 13 Twn 6S Rng 6W</u>                     |
| City State Zip Code  | Distance Direction Nearest Town<br>Miles of   |
| Telephone No. <u>(228) 762-0119</u>  |   |

### Well / Borehole Data

Date drilling started: 2-10-2019 Date drilling completed: 2-29-2019 Hole depth: 100 Hole diameter: 16x10

Location of the source of any surface water used for drilling: NA  
Method of dosing and volume of Chlorine used in drilling and development: Bleach

Logs run (circle all applicable): No log run  Electric  Gamma Ray  Density  Sonic  Neutron Other: \_\_\_\_\_  
Name of organization running log(s): Teaco

Purpose of borehole (check one): Water Well  Geotechnical/Geological Investigation  Ground Source Heat Pump   
Seismic Survey  Other (describe) \_\_\_\_\_

**If drilling is not related to water well construction, skip the remainder of this block**

Purpose of Well (check one): Home  Industrial  Public Supply  Irrigation  Fish Culture  Other: \_\_\_\_\_

If a flowing well, method of flow regulation: Valve \_\_\_\_\_ Other (describe) \_\_\_\_\_

Static Water Level: 9' 10" feet above or below (circle one) land surface Date measured: 3-13-19

Method of Measurement (circle one) steel tape  electric tape  air line other: \_\_\_\_\_

Well depth: 100 Well grouted to a depth of 42 feet Type of grout (circle one): Neat Cement Bentonite  Mix

Casing length: 60 feet Casing diameter: 10" inches Type of casing: 304 SS

Screen length: 40 feet Screen diameter: 10" inches Type of screen: SS Wrap

Screen slot size: .012 inches Setting depth: From 60 feet to 100 feet

Type of completion (circle all applicable):  Gravel packed  Underreamed  Telescoped  Open hole  Natural Development

Other (describe): Casing cemented to top of sand lap back to GL

Top of lap pipe or reduction in casing: GL feet. **If telescoped or more than one screen, describe on next page**

RECEIVED  
APR 05 2019  
BY OLWR



# STATE WELL REPORT

## Part 2

**Pump Installer's Completion Report**  
 Mississippi Department of Environmental Quality  
 Office of Land and Water Resources  
 P.O. Box 2309  
 Jackson, MS 39225  
 (601)961-5210  
 (601)961-5228 (fax)

**For Office Use Only:**

Aquifer: \_\_\_\_\_  
 Well #: L0213  
 Elevation: \_\_\_\_\_

County: Jackson  
 Permit #: M56V-17302  
 Driller: Lyman Well  
 Date completed: 9/17/2019  
*Copy information from block on Part 1*

*This part of the report must be completed by a licensed water well contractor or a licensed pump installer. A copy of Part 1 of the report must be attached and both parts filed with the Department at the above address within 30 days of well completion.*

| Well Owner Information                            | Well Location   |
|---|---|
| Owner Name: <u>JCUA</u>                           | Latitude: <u>30 31 47</u> Longitude: <u>88 32 32</u>  |
| Mailing Address: <u>1225 Jackson Ave.</u>         | Method of Lat/Long (check one): Conventional Survey <input type="checkbox"/> ,<br>USGS quad <input type="checkbox"/> , Hand-held GPS <input type="checkbox"/> , Survey-grade GPS <input type="checkbox"/> |
| <u>Pascagoula MS 39567</u><br>City State Zip Code | <u>NE 1/4 NW 1/4 Sec 13 T 6S R 6W</u>   |
| Telephone No. ( <u>228</u> ) <u>762-0119</u>      | Distance _____ Direction _____ Nearest Town _____<br>_____ Miles _____ of _____   |

| Pump Type<br>Circle one  | Power Type<br>Circle one   |
|--|--|
| Air Lift <input type="checkbox"/> Jet <input type="checkbox"/> <u>Submersible</u>                          | Diesel Engine <input type="checkbox"/> Gasoline Engine <input type="checkbox"/> Natural Gas <input type="checkbox"/> |
| Bucket <input type="checkbox"/> Piston <input type="checkbox"/> Turbine <input type="checkbox"/>           | <u>Electric Motor</u> <input type="checkbox"/> Hand <input type="checkbox"/> Tractor PTO <input type="checkbox"/>    |
| Centrifugal <input type="checkbox"/> Rotary <input type="checkbox"/> Flowing Well <input type="checkbox"/> | Windmill <input type="checkbox"/> Other (specify): _____   |
| Other (specify): _____   | Horse Power Rating of Motor: <u>15</u>   |
| Date Pump Installed: <u>9/17/19</u>  | Setting Depth: <u>82</u> feet  |
| Rated Pump Capacity: <u>450</u> Gallons Per Minute   | Number of Stages: <u>1</u>   |

| Pump Test Data  | Method of Measuring Water Level<br>Circle one   |
|---|---|
| Date Well Tested: <u>9/17/19</u>                              | Air Line <input type="checkbox"/> <u>Electric Measuring Line</u> <input type="checkbox"/> Steel Tape <input type="checkbox"/> |
| Static Water Level (A): <u>10.6</u> Feet Below Land Surface   | Other (specify): _____  |
| Pumping Water Level (B): <u>33'6"</u> Feet Below Land Surface | For flowing well, measured shut in head: _____ feet   |
| Drawdown [(B) - (A)]: <u>23</u> Feet Below Land Surface       | Well yielded _____ GPM with a drawdown of _____ feet after _____ hours of pumping   |
| Test Pumping Rate: <u>351</u> Gallons Per Minute              |   |
| Duration of Pump Test (minimum 4 hours): <u>25</u> hours      |   |

I HEREBY CERTIFY that the above statements are true to the best of my knowledge.

Josh Ladner 0-640 [Signature]  
 Print Name of Pump Installer and License No. (if applicable) Signature of Pump Installer

**RECEIVED**  
**SEP 25 2019**  
**OLWR**



Legend  
📌 JCUA SWTP

RECEIVED  
APR 05 2009  
BY OLWR

📌 JCUA SWTP #2  
66-17301  
L0214


📌 JCUA SWTP #1  
66-17302  
L0213

Google Earth

Untitled Map

© 2013 European Technologies  
© 2013 Google

300 ft

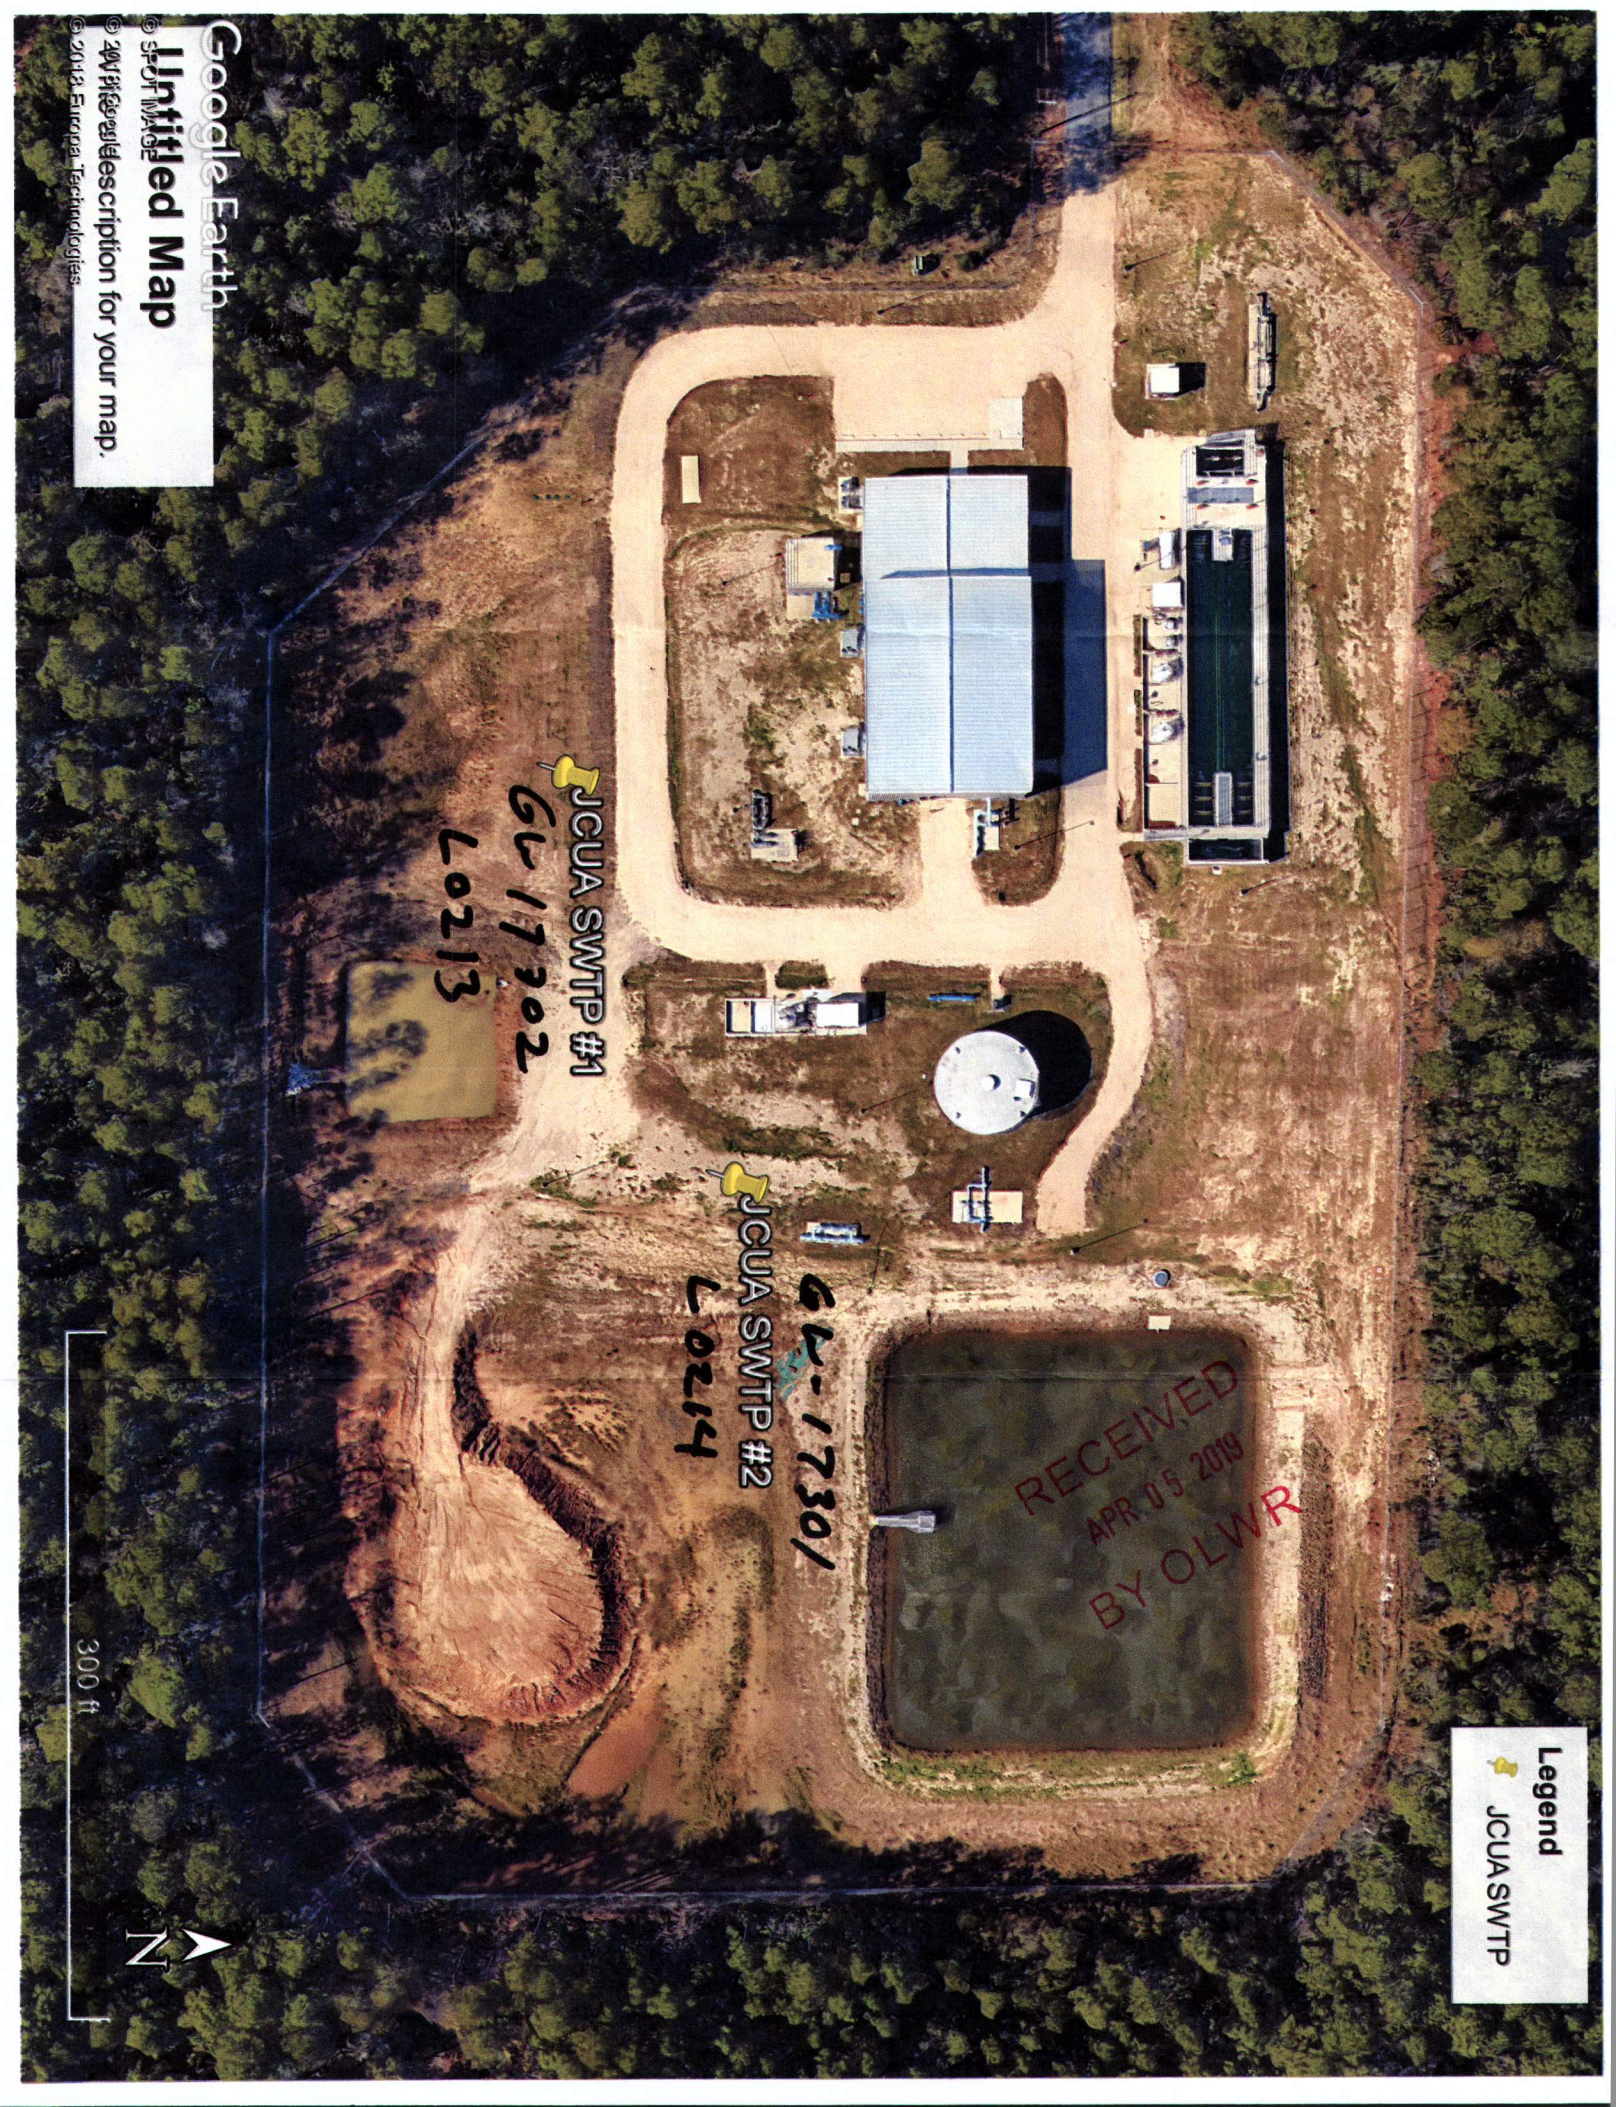



(EASEN HILL)




THREE RIVERS QUADRANGLE  
MISSISSIPPI  
TOPOGRAPHIC SERIES

(HURLEY)

088° 33' 48.1575" W  
030° 33' 11.8590" N

(HARLESTON)

088° 31' 30.7969" W  
030° 33' 11.8590" N

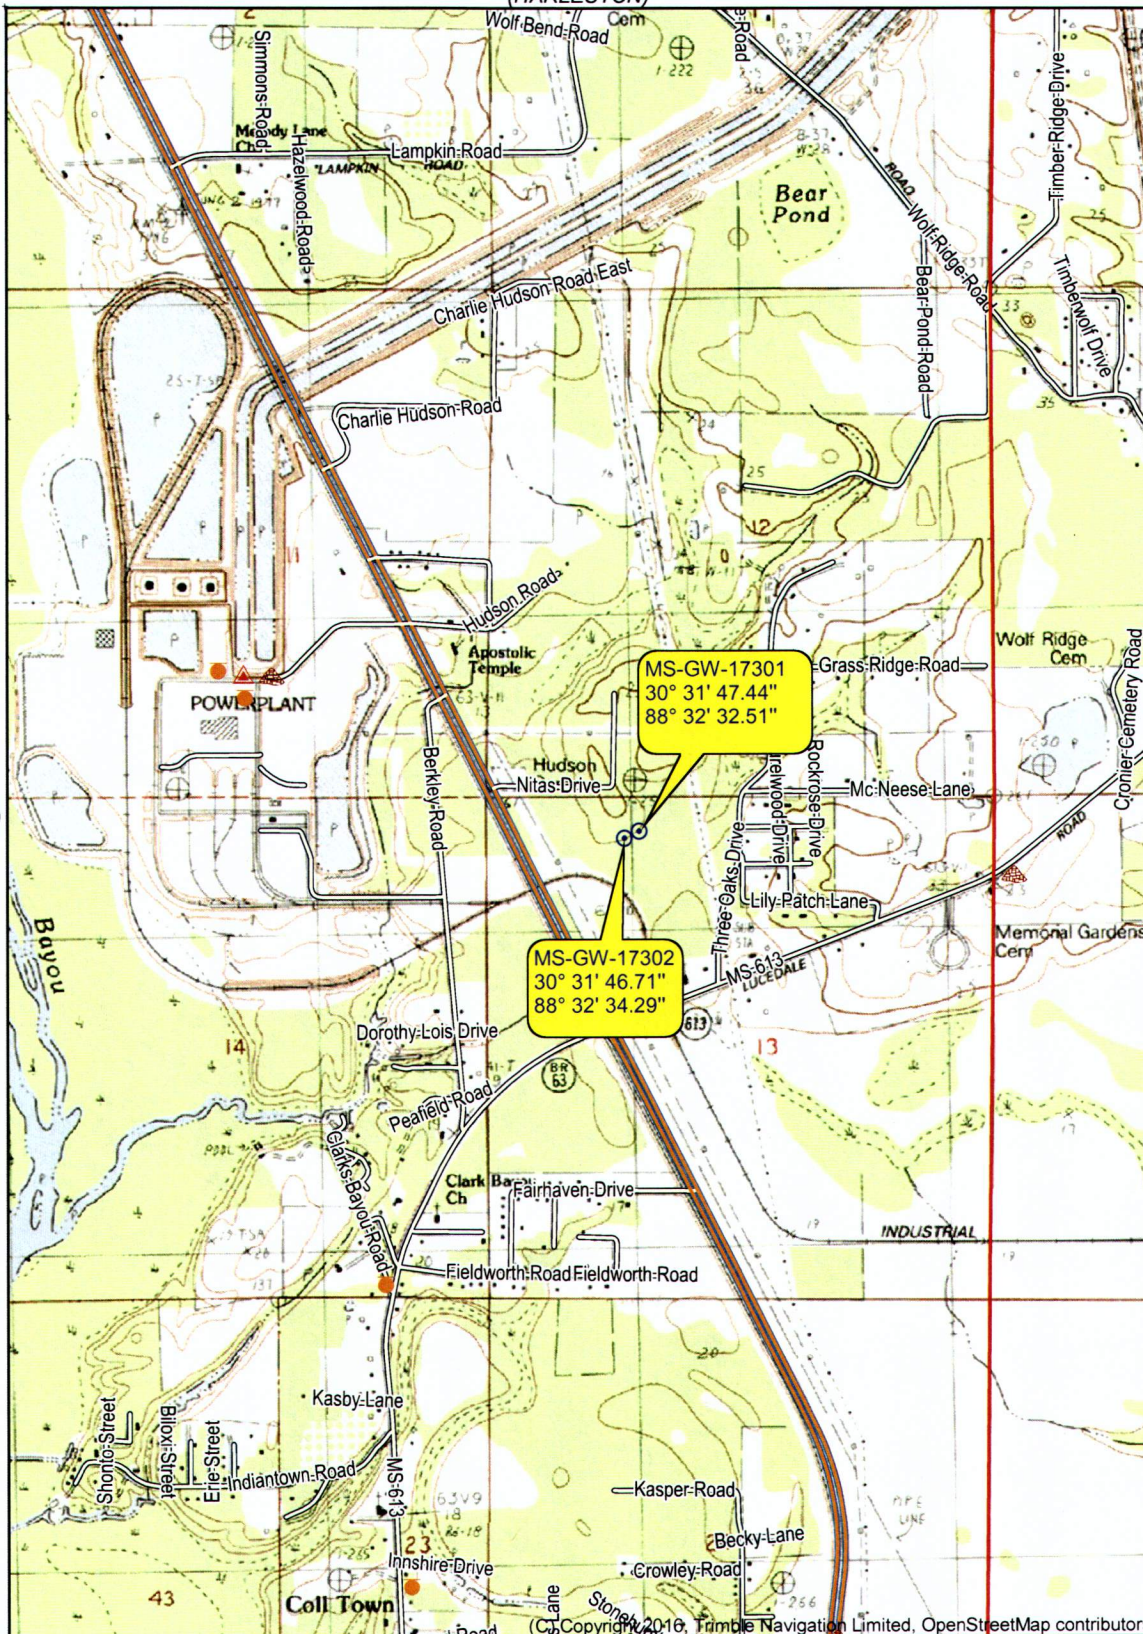

MS-GW-17301  
30° 31' 47.44"  
88° 32' 32.51"

MS-GW-17302  
30° 31' 46.71"  
88° 32' 34.29"

(VANCLEAVE)

(BIG POINT)

030° 30' 24.2564" N  
088° 33' 48.1575" W

(PASCAGOULA NORTH)

030° 30' 24.2564" N  
088° 31' 30.7969" W

(GAUTIER NORTH)

(KREOLE)

Produced by Trimble Terrain Navigator Pro  
Topography based on USGS 1:24,000  
Maps


North American 1983 Datum (NAD83)

To place on the predicted North American  
1927 move the projection lines 22M N and  
2M W

Declination



SCALE 1:24000

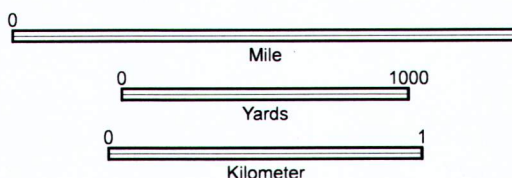

CONTOUR INTERVAL 5 FT

30088-E5-TM-024  
THREE RIVERS, MS  
JAN 1, 1982



Nitas Drive

MS-GW-17301 030° 31' 47.4400" N 088° 32' 32.5'

MS-GW-17302 030° 31' 46.7100" N 088° 32' 34.2900" W

