

JACKSON MISSISSIPPI BOARD OF WATER COMMISSIONERS

L 2000 *Can't locate*

WATER WELL DRILLERS LOG

10-24-61

Date: Oct 24, 1961, Driller: Colville County Jackson

(Name)

(1) Owner of Land: Robin Cain
 (Name)
Escatawpa
 (Address)

(2) Location: 1/4, 1/4, Sec. T6SR64
5 miles North of Escatawpa
 (distance) (direction) (Nearest Town)

(3) Topography: Flat
 (Hilly) (Flat) (Level)


(4) Purpose of Well: Domestic
 (Domestic Irrigation
 Municipal, Industrial, Other)

Description & Color of Materials Sand, Clay, Red Clay, Shell, etc.	Thick- ness Feet	Depth Feet
<u>Clay (yellow)</u>		<u>15</u>
<u>Clay & Sand STRK</u>	<u>10</u>	<u>25</u>
<u>Clay</u>	<u>17</u>	<u>42</u>
<u>Sand</u>	<u>78</u>	<u>120</u>
<u>Clay</u>	<u>111</u>	<u>231</u>
<u>Sand</u>	<u>10</u>	<u>241</u>
		<u>None</u>

Information upon completion of well:

(1) Diameter 1 1/4 inches.
 (2) Total Depth 241 ^{more} feet. 201 well
 (3) Water Level 8'5" feet below top of ground.
 (4) Cased to _____, Size _____
 (5) Screen: Size 1/42 Length 10'
 (6) Were there formations sealed against pollution?
 _____ yes, _____ no.

If YES depth of formation _____
 Why _____
 Drillers Remarks: _____

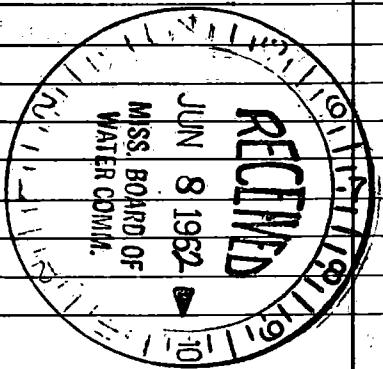

(Use Back Side)

Well No. 798

