

L 2001

8-25-61

Can't locate

WATER WELL DRILLERS LOG

Date: Aug 25, 1961, Driller: Colville County Jackson
 (Name)

(1) Owner of Land: J.D. DOSWELL
 (Name)
Gautier
 (Address)

(2) Location: SW 1/4, SW 1/4, Sec. 4 T6SR6W
10 miles North, of Gautier
 (distance) (direction) (Nearest Town)

(3) Topography: Hilly
 (Hilly) (Flat) (Level)

(4) Purpose of Well: Domestic
 (Domestic Irrigation
 Municipal, Industrial, Other)

Description & Color of Materials Sand, Clay, Red Clay, Shell, etc.	Thick- ness Feet	Depth Feet
<u>sand</u>		<u>8</u>
<u>Clay</u>	<u>42</u>	<u>50</u>
<u>sand</u>	<u>4</u>	<u>54</u>
<u>Clay</u>	<u>40</u>	<u>84</u>
<u>sand</u>	<u>5</u>	<u>89</u>
		<u>166</u>

Information upon completion of well:

(1) Diameter 1 1/2 inches.

(2) Total Depth 89 feet. *well 84*

(3) Water Level 12' feet below top of ground.

(4) Cased to _____, Size _____


(5) Screen: Size 1/4", Length 5

(6) Were any formations sealed against pollution?
 _____ yes, no.

If YES depth of formation _____

Why _____

Drillers Remarks: _____

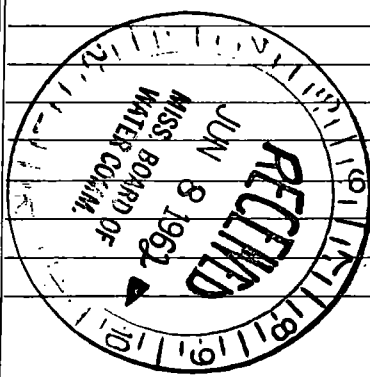

(Use Back Side)

Well No. 89

