

Jackson  
 L 2004  
 9-21-76  
 sub

MISSISSIPPI  
 BOARD OF WATER COMMISSIONERS  
 416 North State Street  
 Jackson, Mississippi 39201

WATER WELL DRILLERS LOG

9-21-76<sup>132</sup> 1976 Corbelle Drilling Jackson  
 date well completed firm name county well located

LANDOWNER:	description of formations encountered	from	to
<u>H. Henderson</u> Big Point, Miss (mailing address)			

WELL LOCATION:  
 sec 23 T 6 N R 6 E  
8 miles N of McP.  
 (distance) (direction) (nearest town)

WELL PURPOSE: pond  
 (home, irrigation, municipal, industrial)

WELL COMPLETION DATA:

- (1) diameter (inches) 2
- (2) total depth (feet) 68
- (3) static water level (feet) 12 <sup>below</sup> <sub>above</sub> top of ground
- (4) casing plastic 63  
(material) (depth)
- (size) If telescope see back.
- (5) screen 5 63  
(length) (depth to top)
- 2" plastic  
(size) (material)
- (6) pump 1 50  
(HP) (yield gpm)
- elec  
(type power)
- (7) electric log no  
(yes or no)

(organization running log)

(8) how well bottom plugged B.P. Jarne


DRILLERS REMARKS:

**RECEIVED**  
 NOV 19 1976

OF WATER COMM

If well telescopes please sketch and show depths.

GROUND LEVEL

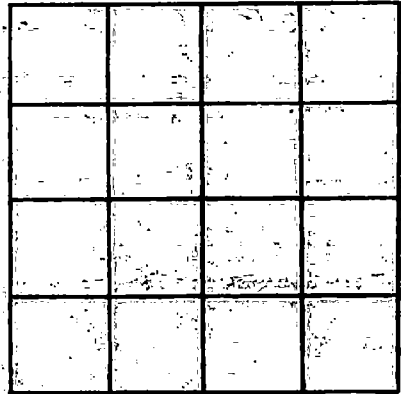

SECTION \_\_\_\_\_

Please indicate well location X.

ADDITIONAL INFORMATION

If more than one screen, show locations of each on sketch.