

JACKSON  
 L 2005  
 9-28-76

MISSISSIPPI  
 BOARD OF WATER COMMISSIONERS  
 416 North State Street  
 Jackson, Mississippi 39201

WATER WELL DRILLERS LOG

ROAST WATER WELL SERVICE

*Jackson*

9-28 1976 date well completed      firm name      county well located

LANDOWNER: *Ruben Bullock*  
 5559 Westmore Dr.  
*Jackson, Miss 39206*  
 (mailing address)

description of formations encountered	from	to
<i>Top Soil</i>	<i>0</i>	<i>3</i>
<i>Blue Clay</i>	<i>3</i>	<i>18</i>
<i>Sand (Med. Fine)</i>	<i>18</i>	<i>30</i>
<i>White Clay</i>	<i>30</i>	<i>43</i>
<i>Sand &amp; Gravel</i>	<i>43</i>	<i>70</i>

WELL LOCATION:  
 sec. *13* T. *6* S. R. *6* W.  
*2 1/2* miles *N.W.* of *Helena*  
 (distance) (direction) (nearest town)

WELL PURPOSE: *Home*  
 (home, irrigation, municipal, industrial)


- WELL COMPLETION DATA:
- (1) diameter (inches) *2 1/2*
  - (2) total depth (feet) *70*
  - (3) static water level (feet) *30'* below top of ground.
  - (4) casing *PVC* *60*  
 (material) (depth)  
*2* If telescope see back.  
 (size)
  - (5) screen *10* *60*  
 (length) (depth to top)  
*2* *PVC*  
 (size) (material)
  - (6) pump \_\_\_\_\_  
 (HP) (yield gpm)  
 (type power)
  - (7) electric log *No*  
 (yes or no)  
 (organization running log)
  - (8) how well bottom plugged *backwash*  
*Value*

DRILLERS REMARKS:

**RECEIVED**  
 MAR 10 1977  
 MISS. BD. OF WATER COMM

If well telescopes please sketch and show depths.

GROUND LEVEL

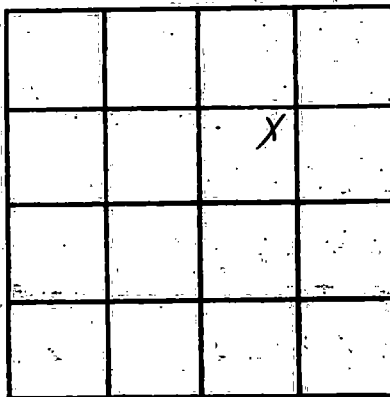

SECTION 13

Please indicate well location X.

ADDITIONAL INFORMATION

If more than one screen, show locations of each on sketch.