

Jackson  
 L 2008  
 2/25/77

MISSISSIPPI  
 BOARD OF WATER COMMISSIONERS  
 416 North State Street  
 Jackson, Mississippi 39201

WATER WELL DRILLERS LOG

Feb 25 1977 <sup>132</sup> Colville Dillingco Jackson  
 date well completed firm name county well located


LANDOWNER: <u>Louis Brown</u>	description of formations encountered	from	to
<u>Wolf Ridge</u> (mailing address)	clay	0	10
WELL LOCATION: sec. <u>1</u> T. <u>6</u> N. R. <u>6</u> E <u>10</u> miles <u>NW</u> of <u>M.P.</u> (distance) (direction) (nearest town)	sand	10	22
WELL PURPOSE: <u>Home</u> (home, irrigation, municipal, industrial)	sand	22	44
WELL COMPLETION DATA: (1) diameter (inches) <u>2 in</u>	sand	44	66
(2) total depth (feet) <u>264</u>	sand	66	88
(3) static water level (feet) <u>34</u> <sup>(below)</sup> <sub>(above)</sub> top of ground.	sand	88	110
(4) casing <u>plastic</u> <u>5'</u> (material) (depth)	sand	110	125
(5) screen <u>2 in</u> <u>5'</u> <u>2:59</u> (size) (length) (depth to top)	clay	125	132
(6) pump <u>1/2</u> <u>5</u> (HP) (yield gpm)	clay	154	160
(7) electric log <u>no</u> (yes or no)	sand	160	176
(8) how well bottom plugged <u>BP</u> <u>value</u>	sand	176	198
DRILLERS REMARKS:	clay	198	200
	clay	200	220
	sand	220	242
	sand	242	264

**RECEIVED**  
 MAR 14 1977

MISS. BD. OF WATER COMM

If well telescopes please sketch and show depths.

GROUND LEVEL

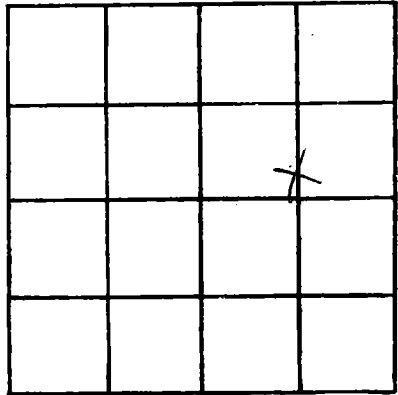

SECTION 1

Please indicate well location X.

ADDITIONAL INFORMATION

A series of horizontal lines for writing additional information, starting below the 'ADDITIONAL INFORMATION' header and extending to the bottom of the page.

If more than one screen, show locations of each on sketch.