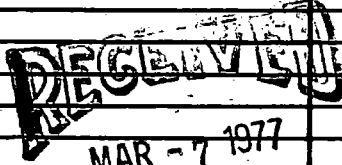


JACKSON
 L 2009
 2/28/77

MISSISSIPPI
 BOARD OF WATER COMMISSIONERS
 416 North State Street
 Jackson, Mississippi 39201


WATER WELL DRILLERS LOG

2/28 1977 *Coast Water Well Service* *Jackson*
 date well completed firm name county/well located

LANDOWNER: <i>Mr. Lawer Co.</i>	description of formations encountered	from	to
+ <i>Jackson Co. Steam Plant</i> <i>Escatawpa, Mo.</i> (mailing address)	<i>top soil</i>	0	10
WELL LOCATION: sec. <u>11</u> T. <u>6</u> R. <u>6</u> <u>6</u> miles <u>N</u> of <u>Escatawpa</u> (distance) (direction) (nearest town)	<i>yellow clay</i>	10	24
WELL PURPOSE: <i>Monitoring</i> (home, irrigation, municipal, industrial)	<i>Coarse Sand + Gravel</i>	24	85
WELL COMPLETION DATA: (1) diameter (inches) <u>2"</u> (2) total depth (feet) <u>85'</u> (3) static water level (feet) <u>13</u> <i>below above</i> top of ground. (4) casing <u>PVC</u> , <u>80'</u> (material) (depth) <u>2"</u> if telescope see back. (size) (5) screen <u>5'</u> , <u>80'</u> (length) (depth to top) <u>2"</u> , <u>PVC</u> (size) (material) (6) pump _____ (HP) (yield gpm) (type power) (7) electric log _____ (yes or no) (organization running log) (8) how well bottom plugged <u>B.W.</u> <u>Value</u>			
DRILLERS REMARKS:	<div style="text-align: center;">  MAR - 7 1977 MISS. BD. OF WATER COMM </div>		

If well telescopes please sketch and show depths.

GROUND LEVEL

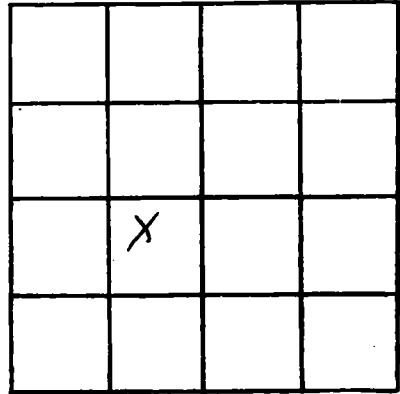

SECTION 11

Please indicate well location X.

ADDITIONAL INFORMATION

If more than one screen, show locations of each on sketch.