

JACKSON
 L 2011
 2/28/77

MISSISSIPPI
 BOARD OF WATER COMMISSIONERS
 416 North State Street
 Jackson, Mississippi 39201

WATER WELL DRILLERS LOG
 COAST WATER WELL SERVICE

2-28 1977 date well completed
 Jackson firm name
 Jackson county well located

LANDOWNER Elsie Fairley
P.O. Box 41
Cocataway Miss 39552
 (mailing address)

description of formations encountered	from	to
Top Soil Sand	0	1
Red Clay	1	14
Sand (Coarse)	14	55

WELL LOCATION:
 sec. 18 T. 6 S. R. 6 W.
3 1/2 miles E. of Venham
 (distance) (direction) (nearest town)

WELL PURPOSE: Home
 (home, irrigation, municipal, industrial)

- WELL COMPLETION DATA:
- (1) diameter (inches) 2
 - (2) total depth (feet) 35
 - (3) static water level (feet) 30 (below top of ground)
 - (4) casing PVC (material), 25 (depth),
2 (size) if telescope see back.
 - (5) screen 10 (length), 25 (depth to top),
2 (size), PVC (material)
 - (6) pump — (HP), — (yield gpm)
— (type power)
 - (7) electric log Yes (yes or no)
— (organization running log)

(8) how well bottom plugged See pump valve

DRILLERS REMARKS: —


RECEIVED

MAR - 9 1977

MISS. BD. OF WATER COMM

If well telescopes please sketch and show depths.

GROUND LEVEL

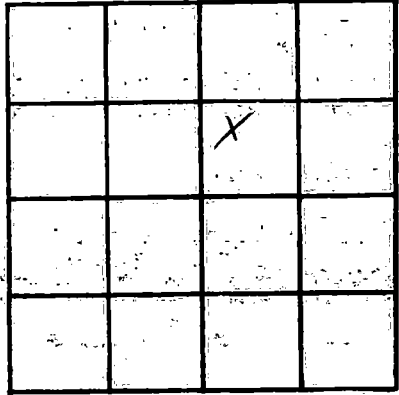

SECTION 18

Please indicate well location X.

ADDITIONAL INFORMATION

If more than one screen, show locations of each on sketch.