

JACKSON  
L 2019  
8-10-79

MISSISSIPPI  
BOARD OF WATER COMMISSIONERS  
416 North State Street  
Jackson, Mississippi 39201

WATER WELL DRILLERS LOG

8-10-1979 date well completed  
Coast Water Well Serv. firm name  
Jackson county well located

LANDOWNER

Jerry Warden  
P.O. Box 1054  
Escatawpa, Miss. 39552  
(mailing address)

description of formations encountered

from to

Top soil	0	3
gray clay	3	53
sand (c)	53	70
Blue clay	70	82
sand (c)	82	142
Blue clay	142	236
sand (m)	236	260

WELL LOCATION:

sec. 24 T 6 R 6  
4 1/2 miles North of Escatawpa  
(distance) (direction) (nearest town)

WELL PURPOSE:

Home  
(home, irrigation, municipal, industrial)

WELL COMPLETION DATA:

- (1) diameter (inches) 2"
- (2) total depth (feet) 260'
- (3) static water level (feet) 45' below top of ground
- (4) casing PVC 250' (material) (depth)  
2" (size) if telescope see back.
- (5) screen 10' 250' (length) (depth to top)  
2" (size) PVC (material)
- (6) pump 1/2 HP 8 (type) (yield gpm)
- (7) electric log No. (yes or no)
- (organization running log)

(8) how well bottom plugged  
Back Wash Valve

DRILLERS REMARKS:


DEPT. OF NATURAL RESOURCES  
BUREAU OF LAND & WATER RESOURCES

FEB 26 1980

RECEIVED

If well telescopes please sketch and show depths.

GROUND LEVEL

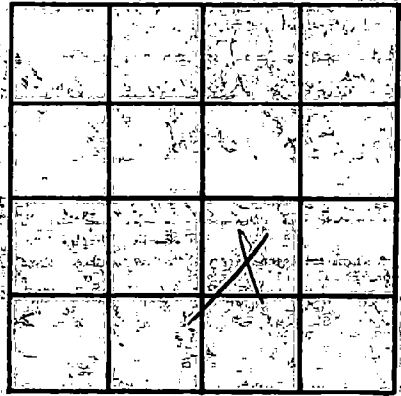

SECTION 24

Please indicate well location X.

ADDITIONAL INFORMATION

If more than one screen, show locations of each on sketch.