

JACKSON  
 L 2020  
 8-17-79

MISSISSIPPI  
 BOARD OF WATER COMMISSIONERS  
 416 North State Street  
 Jackson, Mississippi 39201

WATER WELL DRILLERS LOG

8-17-79 date well completed  
 Coast Water Well Sew. Inc. firm name  
 Jackson county well located

LANDOWNER: G.W. Shell  
 15205 Hwy 63  
 Pascagoula, Miss. 39567  
 (mailing address)

WELL LOCATION:  
 sec. 26 T. 6 R. 6  
 7 miles North of Escatawpa  
 (distance) (direction) (nearest town)

WELL PURPOSE: Home  
 (home, irrigation, municipal, industrial)

WELL COMPLETION DATA:  
 (1) diameter (inches) 2"  
 (2) total depth (feet) 168'  
 (3) static water level (feet) 30' below top of ground.  
 (4) casing PVC 158' (material) (depth)  
 2" (size) if telescope see back.  
 (5) screen 10' 158' (length) (depth to top)  
 2" (size) PVC (material)  
 (6) pump L.V.P. 8 (HP) (yield-gpm)  
 Elect (type power)  
 (7) electric log No (yes or no)  
 (organization running log)

description of formations encountered	from	to
Gray Clay	0	9
Sand Shell	9	64
Blue Clay	64	138
Sand CR	138	168

(8) How well bottom plugged:  
 Back wash Valve

DRILLERS REMARKS:


DEPT. OF NATURAL RESOURCES  
 BUREAU OF LAND & WATER RESOURCES

FEB 26 1980

RECEIVED

If well telescopes please sketch and show depths.

GROUND LEVEL

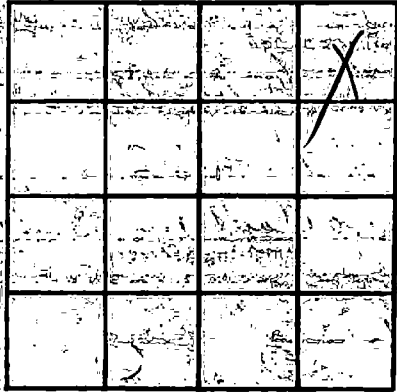

SECTION //

Please indicate well location X.

ADDITIONAL INFORMATION

Multiple horizontal lines for additional information.

If more than one screen, show locations of each on sketch.