

JACKSON
 L 2026
 8-11-80
 Aug 11 1980

MISSISSIPPI
 BOARD OF WATER COMMISSIONERS
 416 North State Street
 Jackson, Mississippi 39201

WATER WELL DRILLERS LOG

date well completed 1980
 firm name Belville Drilling Co
 county well located Jackson

LANDOWNER: Paul Ingle
Big Point, Miss.
 (mailing address)

WELL LOCATION:
 sec. 7 T. 6 N. R. 6 E.
10 miles North of MP
 (distance) (direction) (nearest town)

WELL PURPOSE: Home
 (home, irrigation, municipal, industrial)

WELL COMPLETION DATA:
 (1) diameter (inches) 2"
 (2) total depth (feet) 195
 (3) static water level (feet) 21 below above top of ground.
 (4) casing Galv. 190
 (material) (depth)
 (size) If telescope see back.
 (5) screen 5' 190
 (length) (depth to top)
211 plastic
 (size) (material)
 (6) pump 1 15
 (HP) (yield gpm)
dec
 (type power)
 (7) electric log no
 (yes or no)
 (organization running log)
 (8) how well bottom plugged B.P. Ingle

description of formations encountered	from	to
Clay	0	15
sand	15	22
sand	22	44
sand	44	66
sand	66	70
Clay	70	88
Clay	88	110
Clay	110	132
Clay	132	154
Clay	154	176
Clay	176	180
sand	180	195

DEPT. OF NATURAL RESOURCES
 BUREAU OF LAND & WATER RESOURCES


JUN 5 - 1981

RECEIVED

DRILLERS REMARKS:

If well telescopes please sketch and show depths.

GROUND LEVEL

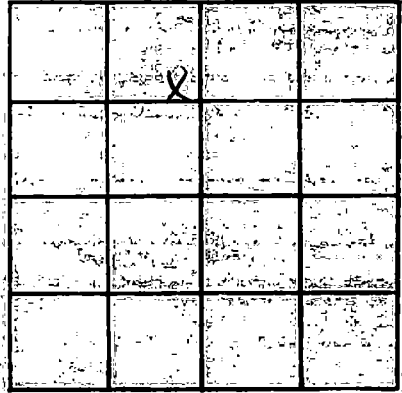

SECTION 7

Please indicate well location: X

ADDITIONAL INFORMATION

If more than one screen, show locations of each on sketch.