

MISSISSIPPI DEPARTMENT OF NATURAL RESOURCES

Bureau of Land and Water Resources

Southport Mall

P.O. Box 10631

Jackson, Mississippi 39209

WATER WELL DRILLERS LOG

Jackson
L 7027
1-22-81

Jan. 23rd 1981 date well completed
81 Coast Water Well Serv. firm name
Jackson county well located

LANDOWNER	Description of formations encountered	from	to
DeLany Mitchell 3702 Jefferson Ave. Pasadena, Miss. (mailing address) 38517	Top soil	0	3'
	Red Clay	3'	30'
	O-sand g.	30'	100'
	B-Clay	100'	175'
	M-Sand	175'	198'

WELL LOCATION:
sec. 1 T-6 S R-6 W
7 1/2 miles N of ESCATAWPA
(distance) (direction) (nearest town)

WELL PURPOSE: Home
(home, irrigation, municipal, industrial)

- WELL COMPLETION DATA:
- (1) diameter (inches) 2"
 - (2) total depth (feet) 198'
 - (3) static water level (feet) 45' (below top of ground)
 - (4) casing PVC, 188' (material), (depth)
2" (size) If telescope see back.
 - (5) screen 10' (length), 188' (depth to top)
2" (size), PVC (material)
 - (6) pump 1 h.p. (HP), 10 (yield gpm)
Elect. (type power)
 - (7) electric log Elect. (yes or no)
- (organization running log)

(8) how well bottom plugged
back wash valve

DEPT. OF NATURAL RESOURCES
BUREAU OF LAND & WATER RESOURCES


APR - 6 1981

DRILLERS REMARKS:

RECEIVED

If well telescopes please sketch and show depths.

GROUND LEVEL

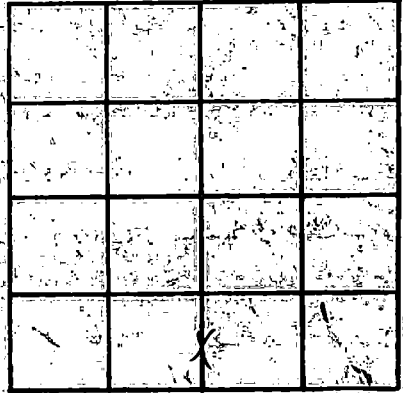

SECTION 1

Please indicate well location X.

ADDITIONAL INFORMATION

If more than one screen, show locations of each on sketch.