

MISSISSIPPI DEPARTMENT OF NATURAL RESOURCES

Bureau of Land and Water Resources

Southport Mall

P.O. Box 10631

Jackson, Mississippi 39209

WATER WELL DRILLERS LOG

JACKSON
L 2088
1-22-87

1-22-87 date well completed 81 Coastal Water Well Sew. firm name Jackson county well located

LANDOWNER: Shirley L. Mitchell
3702 Jefferson Ave
Pascagoula, Miss.
(mailing address) 39567

description of formations encountered	from	to
<u>Top soil</u>	<u>0</u>	<u>3'</u>
<u>Red Clay</u>	<u>3'</u>	<u>40'</u>
<u>Coarse sand gray</u>	<u>40'</u>	<u>70'</u>

WELL LOCATION:
sec. L-6 T. 6 R. 6
7 1/2 miles N of ESCATAWPA
(distance) (direction) (nearest town)

WELL PURPOSE: home
(home, irrigation, municipal, industrial)

- WELL COMPLETION DATA:
- (1) diameter (inches) 2"
 - (2) total depth (feet) 70'
 - (3) static water level (feet) 15' ^(below) _(above) top of ground.
 - (4) casing PVC 60'
(material) (depth)
2" If telescope see back.
(size)
 - (5) screen 10' 60'
(length) (depth to top)
2" PVC
(size) (material)
 - (6) pump Electric (HP) _____ (yield gpm)
(type power)
 - (7) electric log No.
(yes or no)

(organization running log)

(8) how well bottom plugged: Back Wash Valve

DRILLERS REMARKS:


DEPT. OF NATURAL RESOURCES
BUREAU OF LAND & WATER RESOURCES

APR - 6 1987

RECEIVED

If well telescopes please sketch and show depths.

GROUND LEVEL

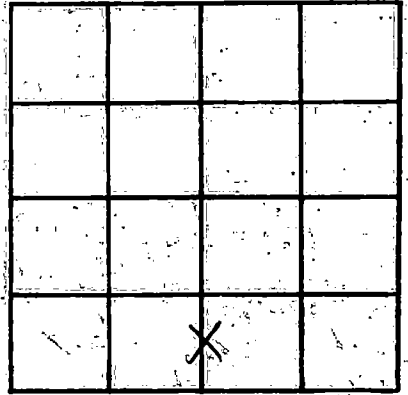

SECTION /

Please indicate well location X.

ADDITIONAL INFORMATION

If more than one screen, show locations of each on sketch.