

MISSISSIPPI DEPARTMENT OF NATURAL RESOURCES

Bureau of Land and Water Resources

Southport Mall

P.O. Box 10631

Jackson, Mississippi 39209

WATER WELL DRILLERS LOG

Jackson
L 2029
4-28-81

4-28-81 date well completed
81 Coast Water Well Serv. firm name
Jackson county well located

LANDOWNER: Jerry Lee
300 Northwood
Pascagoula Miss
(mailing address) 38567

WELL LOCATION:
sec. 39 T-6 S R-6 W
4 miles ESE of VANCLEAVE
(distance) (direction) (nearest town)

WELL PURPOSE: Home
(home, irrigation, municipal, industrial)

WELL COMPLETION DATA:

- (1) diameter (inches) 2"
- (2) total depth (feet) 438'
- (3) static water level (feet) 31' below top of ground
- (4) casing PVC 428' (material) (depth)
2" (size) if telescope see back.
- (5) screen 10' 428' (length) (depth to top)
2" PVC (size) (material)
- (6) pump 1/2 HP 12 (yield gpm)
Elex (type power)
- (7) electric log No. (yes or no)
(organization running log)

description of formations encountered	from to	
Top soil	0	1'
Red coarse sand + gravel	1'	37'
White clay	37'	51'
Blue clay	51'	318'
Gray med. sand	318'	324'
Blue clay	324'	370'
Blue clay + streak of sand	370'	405'
Gray coarse sand	405'	438'

DEPT. OF NATURAL RESOURCES
BUREAU OF LAND & WATER RESOURCES

JUN 2 - 1981


RECEIVED

(8) How well bottom plugged
Back wood valve

DRILLERS REMARKS:

If well telescopes please sketch and show depths.

GROUND LEVEL

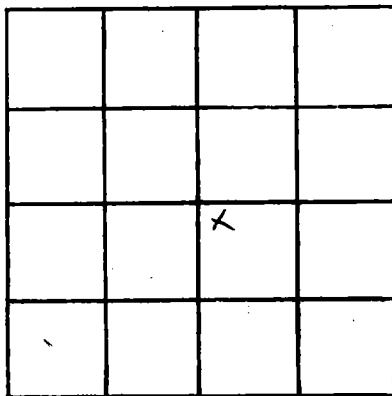

SECTION 39

Please indicate well location X.

ADDITIONAL INFORMATION

If more than one screen,
show locations of each on sketch.