

MISSISSIPPI DEPARTMENT OF NATURAL RESOURCES

Bureau of Land and Water Resources

Southport Mall

P.O. Box 10631

Jackson, Mississippi 39209

WATER WELL DRILLERS LOG

Jackson
L 2081
6-16-81

6-16-81 date well completed
Coast Water Well Service firm name
Jackson county well located

LANDOWNER

Bobby Rogers

description of formations encountered

from to

11012 Hwy 613

Top soil

0 3'

Passport, Miss.
(mailing address) 37567

Gray Clay

3' 25'

WELL LOCATION:

sec. 23 T-6 S R-6 W
5 1/2 miles N of ESCATAWPA
(distance) (direction) (nearest town)

O sand - small

25' 125'

Blue Clay

125' 145'

Coarse sand

145' 180'

WELL PURPOSE:

(home, irrigation, municipal, industrial)

Home

Blue Clay

180' 250'

WELL COMPLETION DATA:

- (1) diameter (inches) 2"
- (2) total depth (feet) 360'
- (3) static water level (feet) 20' (below top of ground)
- (4) casing PVC 350' (material) (depth)
2" (size) If telescope see back.
- (5) screen 10' 350' (length) (depth to top)
2" PVC (size) (material)
- (6) pump 1/2 HP (type power) (yield gpm)
- (7) electric log No (yes or no)

Coarse sand

250' 270'

Blue Clay

270' 330'


O sand

330' 360'

(organization running log)

(8) how well bottom plugged
Back Wash Valve

DRILLERS REMARKS:

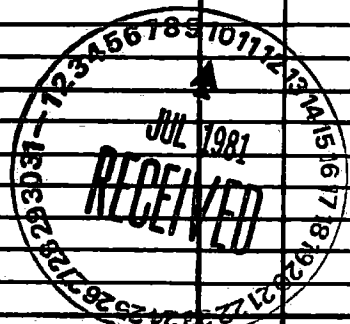

If well telescopes, please sketch and show depths.

GROUND LEVEL

			X

SECTION 2B

Please indicate well location X.

ADDITIONAL INFORMATION

If more than one screen, show locations of each on sketch.