

MISSISSIPPI DEPARTMENT OF NATURAL RESOURCES

Bureau of Land and Water Resources

Southport Mall

P.O. Box 10631

Jackson, Mississippi 39209

COASTAL WATER WELL DRILLERS LOG

ROUTE 1 BOX 618

BILOXI, MISS. Firm name 39532

Jackson county well located

Jackson  
L 7033

3/14/82 19  
date well completed

LANDOWNER

Byron King

P.O. Box 340

Escatawpa, Miss 39532  
(mailing address)

WELL LOCATION:

sec. 11 T. 6 S. R. 6 E.

Alcorn State Univ. (distance) (direction) (nearest town)

WELL PURPOSE:

(home, irrigation, municipal, industrial) home

WELL COMPLETION DATA:

- (1) diameter (inches) 2"
- (2) total depth (feet) 185'
- (3) static water level (feet) 55' below top of ground.

(4) casing PVC, 175' (material) (depth)

(size) If telescope see back.

(5) screen 10' length, 175' depth to top

2" (size) PVC (material)

(6) pump 1/2 HP, 12 (yield gpm)

Electric (type power)

(7) electric log Yes (yes or no)

(organization running log)

(8) how well bottom plugged 2" bedrock

DRILLERS REMARKS: 19-B

description of formations encountered

description of formations encountered	from	to
top soil	1	2
red clay	2	15
red sand	15	35
soft blue clay	35	70
hard blue clay	70	120
lime	120	155
red sand	155	170
granitic sand	170	185


DEPT. OF NATURAL RESOURCES  
BUREAU OF LAND & WATER RESOURCES

OCT 14 1982

RECEIVED

If well telescopes please sketch and show depths.

**GROUND LEVEL**

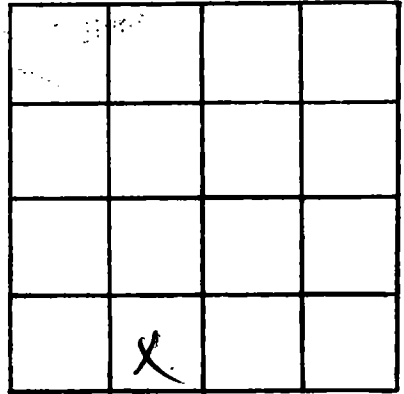

**SECTION** \_\_\_\_\_

Please indicate well location X.

**ADDITIONAL INFORMATION**

If more than one screen, show locations of each on sketch.