

MISSISSIPPI DEPARTMENT OF NATURAL RESOURCES

Bureau of Land and Water Resources

Southport Mall

P.O. Box 10631

Jackson, Mississippi 39209

WATER WELL DRILLERS LOG

Jackson
L 2085

11-12-82, 19 Fry Fogle Water Well Co. Jackson
date well completed firm name county well located

LANDOWNER: Dayton Collins
Route 4, Box 225-G
Ocean Springs, MS 39564
(mailing address)

WELL LOCATION:
sec. 5 T. 6 N. R. 6 E.
4 miles East of VanLare
(distance) (direction) (nearest town)

WELL PURPOSE:
(home, irrigation, municipal, industrial)

WELL COMPLETION DATA:
(1) diameter (inches) 4
(2) total depth (feet) 465
(3) static water level (feet) 50 below above top of ground.
(4) casing PVC, 455' (material) (depth)
no (size) If telescope see back.
(5) screen 10' (length), 455' (depth to top)
4" (size), PVC (material)
(6) pump 1 (HP), 30 (yield gpm)
C.P. (type power)
(7) electric log no (yes or no)
no (organization running log)
(8) how well bottom plugged PVC Ball check

| description of formations encountered | from | to |
|---------------------------------------|------|-----|
| TOP SOIL | 0 | 5 |
| Clay BROWN | 5 | 15 |
| | 15 | 35 |
| Clay | 35 | 60 |
| sand | 60 | 75 |
| Clay | 75 | 105 |
| SAND | 105 | 115 |
| Clay | 115 | 119 |
| SAND | 190 | 220 |
| Clay | 220 | 300 |
| Clay + Sand | 300 | 400 |
| Fine sand | 400 | 420 |
| Fine Blue sand | 420 | 465 |

DEPT. OF NATURAL RESOURCES
BUREAU OF LAND & WATER RESOURCES


FEB - 7 1983

RECEIVED

DRILLERS REMARKS:

If well telescopes please sketch and show depths.

GROUND LEVEL

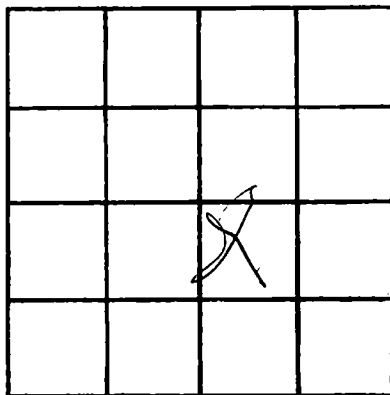

SECTION 39

Please indicate well location X.

ADDITIONAL INFORMATION

If more than one screen, show locations of each on sketch.