

Jackson
L 7037

MISSISSIPPI DEPARTMENT OF NATURAL RESOURCES
Bureau of Land and Water Resources
Southport Mall
P.O. Box 10631
Jackson, Mississippi 39209
WATER WELL DRILLERS LOG

2-5 1983 Pierce Drilling Co. Jackson
date well completed firm name county well located

LANDOWNER: <u>Vagon Jackson</u>	description of formations encountered	from	to
<u>Wade, M.S.</u> (mailing address)	<u>Top Soil</u> <u>Black Clay</u> <u>Good Sand</u>	<u>0</u> <u>10</u> <u>15</u>	<u>10</u> <u>15</u> <u>45</u>
WELL LOCATION: sec. <u>2</u> T <u>6</u> N R <u>6</u> E <u>3</u> miles <u>South</u> of <u>3-Rivers</u> (distance) (direction) (nearest town)			
WELL PURPOSE: <u>(home)</u> irrigation, municipal, industrial			
WELL COMPLETION DATA:			
(1) diameter (inches) <u>2"</u>			
(2) total depth (feet) <u>45'</u>			
(3) static water level (feet) <u>20'</u> <u>below</u> above top of ground.			
(4) casing <u>Plastic</u> , <u>40'</u> (material) (depth) <u>0</u> if telescope see back. (size)			
(5) screen <u>5</u> , <u>4.5'</u> (length) (depth to top)			
<u>006</u> , <u>Plastic</u> (size) (material)			
(6) pump <u>1/2</u> , <u>6</u> (HP) (yield gpm)			
<u>Electric</u> (type power)			
(7) electric log <u>(yes or no)</u>			
(organization running log)			
(8) how well bottom plugged <u>BW</u>			
DRILLERS REMARKS:			


DEPT. OF NATURAL RESOURCES
BUREAU OF LAND & WATER RESOURCES

MAY 24 1983

RECEIVED

If well telescopes please sketch and show depths.

GROUND LEVEL

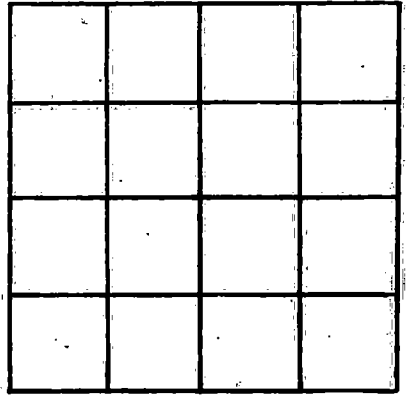

SECTION _____

Please indicate well location X.

ADDITIONAL INFORMATION

If more than one screen, show locations of each on sketch.