

MISSISSIPPI DEPARTMENT OF NATURAL RESOURCES

Bureau of Land and Water Resources

Southport Mall

P.O. Box 10631

Jackson, Mississippi 39209

WATER WELL DRILLERS LOG

Jackson
L7038

3-22-83 19 Coast Water Well Sew. Jackson
date well completed firm name county well located

LANDOWNER: Monty Holder
Rt 4-Box 225
Ocean Springs, Miss.
(mailing address) 39564

description of formations encountered	from	to
<u>Top soil</u>	<u>0</u>	<u>2'</u>
<u>Red Clay</u>	<u>2'</u>	<u>10'</u>
<u>Red Coarse sand & gravel</u>	<u>10'</u>	<u>25'</u>
<u>Blue Clay</u>	<u>25'</u>	<u>102'</u>
<u>gray. Coarse sand</u>	<u>102'</u>	<u>112'</u>

WELL LOCATION:
sec. 39 T. 6 S. R. 6 E
4 miles ESE of VAN CLEAVE
(distance) (direction) (nearest town)

WELL PURPOSE: Home
(home, irrigation, municipal, industrial)

WELL COMPLETION DATA:

(1) diameter (inches) 2"

(2) total depth (feet) 112'

(3) static water level (feet) 6' below top of ground.

(4) casing PVC 102'
(material) (depth)
2"
(size) If telescope see back.

(5) screen 10' 102'
(length) (depth to top)
2" PVC
(size) (material)

(6) pump 1/2 h.p. 13
(HP) (yield gpm)
Elect.
(type power)

(7) electric log No.
(yes or no)
(organization running log)

(8) how well bottom plugged Back wash valve

DRILLERS REMARKS:


DEPT. OF NATURAL RESOURCES
BUREAU OF LAND & WATER RESOURCES

APR 28 1983

RECEIVED

If well telescopes please sketch and show depths.

GROUND LEVEL

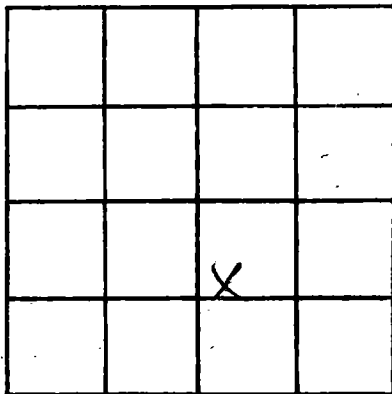

SECTION 39

Please indicate well location X.

ADDITIONAL INFORMATION

If more than one screen, show locations of each on sketch.