

MISSISSIPPI DEPARTMENT OF NATURAL RESOURCES

Jackson  
L2039

Bureau of Land and Water Resources  
Southport Mall  
P.O. Box 10631

JUL 27 1983 Jackson, Mississippi 39209

WATER WELL DRILLERS LOG

6-3-83 RECEIVED  
date well completed firm name Well Sew. Jackson county well located

LANDOWNER: Larry Porter  
14504 Bouffon Rd.  
Pascagoula, Miss.  
(mailing address) 39567

description of formations encountered	from	to
Top soil	0	3'
Red Clay	3'	10'
light blue clay	10'	18'
blue clay	18'	45'
Red coarse sand	45'	70'

WELL LOCATION:  
sec. 1 T. 6 S. R. 6 E.  
7 miles (distance) N ESCATAWPA (direction) (nearest town)

WELL PURPOSE: Home  
(home, irrigation, municipal, industrial)

Red coarse sand & gravel	70'	92'
--------------------------	-----	-----

WELL COMPLETION DATA:

- (1) diameter (inches) 2"
- (2) total depth (feet) 215'
- (3) static water level (feet) 35' below top of ground
- (4) casing PVC 205' (material) (depth)  
2" (size) if telescope see back.
- (5) screen 10' 205' (length) (depth to top)  
2" PVC (size) (material)
- (6) pump 1/2 hp. 7- (HP) (yield gpm)  
Elec. (type power)
- (7) electric log No (yes or no)

Blue Clay	92'	172'
Blue Clay + pinkish sand	172'	190'
Grey coarse sand	190'	215'


(organization running log)

(8) how well bottom plugged  
back wash valve

DRILLERS REMARKS:

If well telescopes please sketch and show depths.

GROUND LEVEL

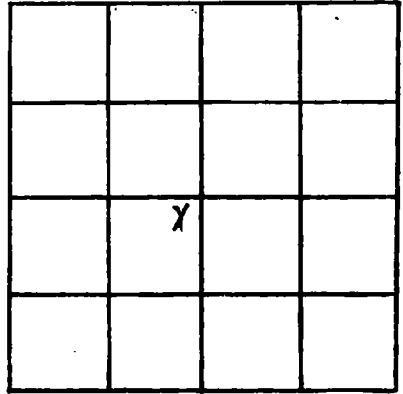

SECTION     

Please indicate well location X.

ADDITIONAL INFORMATION

If more than one screen,  
show locations of each on sketch.