

MISSISSIPPI DEPARTMENT OF NATURAL RESOURCES

Bureau of Land and Water Resources

Southport Mall

P.O. Box 10631

Jackson, Mississippi 39209

WATER WELL DRILLERS LOG

Jackson
L 2041

9-14-83
date well completed

Coast Water Well Serv. Jackson
firm name county well located

LANDOWNER: *Stewart Frederick*
2426 Tyler
Pascoulay Miss.
(mailing address) *39567*

description of formations encountered	from	to
<i>Top soil-Rchy</i>	<i>0</i>	<i>15'</i>
<i>Coarse sand & gravel</i>	<i>15'</i>	<i>20'</i>
<i>Blue Clay</i>	<i>80'</i>	<i>82'</i>
<i>Coarse sand & gravel</i>	<i>82'</i>	<i>126'</i>

WELL LOCATION:
sec. *36-T-6S* R. *6E*
2 miles *N* of *ESCATAWA*
(distance) (direction) (nearest town)

WELL PURPOSE: *Home*
(home, irrigation, municipal, industrial)

WELL COMPLETION DATA:

(1) diameter (inches) *2"*

(2) total depth (feet) *126*

(3) static water level (feet) *24* *below* top of ground

(4) casing *PVC*, *116'*
(material) (depth)

2"
(size) If telescope see back.

(5) screen *10'*, *116'*
(length) (depth to top)

2", *PVC*
(size) (material)

(6) pump *1hp.*, *70*
(HP) (yield gpm)

Elect.
(type power)

(7) electric log *No.*
(yes or no)

(organization running log)

(8) how well bottom plugged *Back wash valve*

DEPT. OF NATURAL RESOURCES
BUREAU OF LAND & WATER RESOURCES


OCT 14 1983

RECEIVED

DRILLERS REMARKS:

If well telescopes please sketch and show depths.

GROUND LEVEL

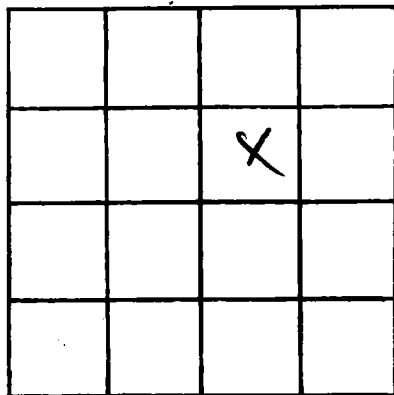

SECTION _____

Please indicate well location X.

ADDITIONAL INFORMATION

If more than one screen, show locations of each on sketch.