

MISSISSIPPI DEPARTMENT OF NATURAL RESOURCES

Bureau of Land and Water Resources

Southport Mall

P.O. Box 10631

Jackson, Mississippi 39209

WATER WELL DRILLERS LOG

Jackson
L2045

3-21-84 date well completed
Coast Water Well Sew. firm name
Jackson county well located

LANDOWNER: Glenn Dennon
4909 Nanny Ave
Brazzangoula Miss.
(mailing address) 39527

description of formations encountered	from	to
Top soil	0	2'
Red Clay	2'	10'
Blue Clay	10'	25'
Gray Coarse sand	25'	60'

WELL LOCATION:
sec. 35 T. 6 N. R. 6 W.
2 1/2 miles (distance) N (direction) of ESCATAWAMP (nearest town)

WELL PURPOSE: Home
(home, irrigation, municipal, industrial)

WELL COMPLETION DATA:

- (1) diameter (inches) 2"
- (2) total depth (feet) 60'
- (3) static water level (feet) 34' ^{below} ~~above~~ top of ground.
- (4) casing PVC (material), 50' (depth)
- 2" (size) if telescope see back.
- (5) screen 10' (length), 50' (depth to top)
- 2" (size), PVC (material)
- (6) pump _____ (HP), _____ (yield gpm)
- Electric (type power)
- (7) electric log No. (yes or no)
- _____ (organization running log)
- (8) how well bottom plugged Back wash valve

DRILLERS REMARKS:


DEPT. OF NATURAL RESOURCES
BUREAU OF LAND & WATER RESOURCES

APR 30 1984

RECEIVED

If well telescopes please sketch and show depths.

GROUND LEVEL

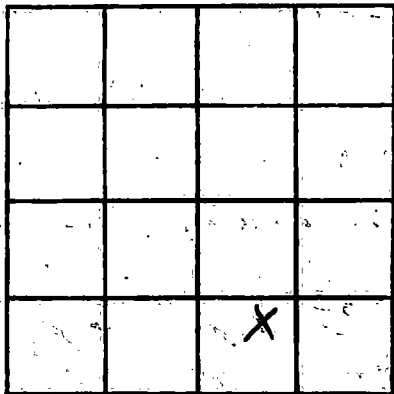

SECTION 35

Please indicate well location X.

ADDITIONAL INFORMATION

If more than one screen, show locations of each on sketch.