

MISSISSIPPI DEPARTMENT OF NATURAL RESOURCES

Bureau of Land and Water Resources

Southport Mall

P.O. Box 10631

Jackson, Mississippi 39209

WATER WELL DRILLERS LOG

Jackson
L 2648

12-28-85 19 Coastwater Well Jackson
date well completed firm name county well located

LANDOWNER: JH Walter

Escatawpa, MS.
(mailing address) 39112

WELL LOCATION:
sec. 11 T. 6 N. R. 6 E
6 miles (distance) N of ESCATAWPA (nearest town)

WELL PURPOSE: home
(home, irrigation, municipal, industrial)

WELL COMPLETION DATA:

- (1) diameter (inches) 2"
- (2) total depth (feet) 430'
- (3) static water level (feet) 105 below top of ground
- (4) casing PVC 420'
(material) (depth)
2" if telescope see back.
(size)
- (5) screen 10' 420'
(length) (depth to top)
2" PVC
(size) (material)
- (6) pump 2 8
(HP) (yield gpm)
Elect
(type power)
- (7) electric log no
(yes or no)
(organization running log)
- (8) how well bottom plugged Backwash valve


description of formations encountered	from	to
Top soil	0	2
Brown Clay	2	10
Blue Clay	10	28
White Coarse sand w/ Gravel	28	90
Streaks of sand + Clay	90	105
White Coarse sand	105	116
Blue Clay	116	133
Med sand	133	148
Blue Clay	148	419
Med Gray sand	419	430

RECEIVED
FEB - 7 1986
Department of Natural Resources
Bureau of Land & Water Resources

DRILLERS REMARKS: _____

If well telescopes please sketch and show depths.

GROUND LEVEL

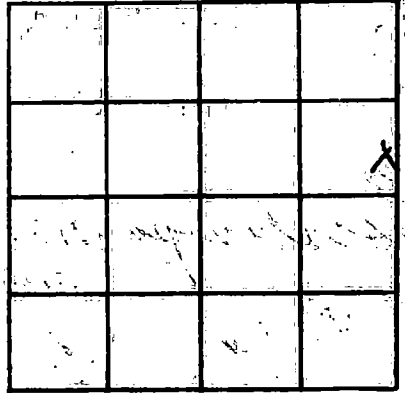

SECTION 11

Please indicate well location X.

ADDITIONAL INFORMATION

RECEIVED
FEB -7 1986

If more than one screen, show locations of each on sketch.

Department of Natural Resources
Bureau of Land & Water Resources