

## Bureau of Land and Water Resources

**Jackson, Mississippi 39209**

# WATER WELL DRILLERS LOG

|                     |       |
|---------------------|-------|
| COUNTY WELL LOCATED |       |
| Jackson             |       |
| WELL NUMBER         | CODED |
| 2049                |       |
| DATE WELL COMPLETED |       |
| 4-27-87             |       |

|                       |
|-----------------------|
| PERMIT NUMBER         |
|                       |
| NAME OF DRILLING FIRM |
| Coast Water           |
| Well Service          |

NAME & MAILING ADDRESS OF LANDOWNER

Ray Rogers

2707 Pecan Ave

Pascagoula Ms

WELL LOCATION: SEC. TOWNSHIP RANGE

36 6 N 6 E

DISTANCE DIRECTION NEAREST TOWN

- - Pascagoula

OTHER LANDMARK

WELL PURPOSE: Home, Irrigation, Municipal, Industrial, Fish Pond, etc.

lawn care.

## WELL DATA

|   |                             |                                    |
|---|-----------------------------|------------------------------------|
| Well Depth<br>75'   | Casing Diameter (In.)<br>2" | Casing Length (Ft.)<br>65'         |
| Type of Casing<br>PVC   | Hole Depth<br>75'           | Depth to Static Water Level<br>12' |
| TYPE OF COMPLETION: (Circle One or More):<br>Gravel Packed, Underreamed, Telescoped,<br>Natural Development, Open Hole, Other<br>(Describe) |                             |                                    |
| Top of Lap Pipe or Reduction in Casing<br>FEET IF TELESCOPED OR MORE THAN ONE SCREEN: USE BACK PAGE   |                             |                                    |

## SCREEN DATA

|                        |                     |                              |
|------------------------|---------------------|------------------------------|
| Diameter - Inches<br>2 | Length - Feet<br>10 | Slot Size - Inches<br>008    |
| Screen Type<br>PVC     |                     | Depth to Bottom - Feet<br>75 |

### PUMP DATA

PUMP TYPE (Circle One):  
Submersible, Turbine, Jet Flowing Well,  
Other (Describe) \_\_\_\_\_

POWER TYPE (Circle One):  
Electric, Tractor, Diesel, Gasoline, Butane,  
Other (Describe) \_\_\_\_\_

| Pump Capacity (GPM) | No. of Stages | Setting Depth |
|---------------------|---------------|---------------|
| 12                  | 2             | — FT.         |

PUMP TEST

Well yielded \_\_\_\_\_ GPM with  
a drawdown of \_\_\_\_\_ ft.  
after \_\_\_\_\_ hours of pumping

## LOG DATA

TYPE OF LOG RUN (Circle One): No Log Run  
 Electric, Gamma Ray, Density, Sonic, Neutron,  
 Other (Describe) \_\_\_\_\_

---

Name of Organization Running Log \_\_\_\_\_


**GEOLOGIC DATA (Office Use Only)**

| Surface Elev.     | Geologic Unit | Unit Thickness | Depth to Top |
|-------------------|---------------|----------------|--------------|
| Subs. SWL         | Date          | Analysis       | Aquifer Test |
| Driller's Remarks |               |                |              |
|                   |               |                |              |
|                   |               |                |              |

[illegible]

If well telescopes please  
sketch and show depths.

GROUND LEVEL

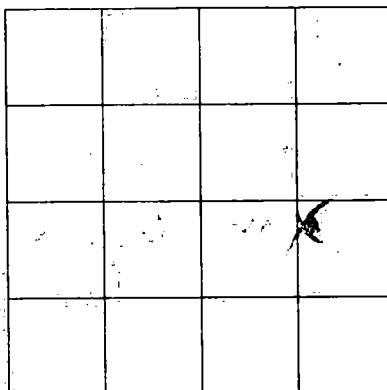

SECTION 36

Please indicate well location X.

ADDITIONAL INFORMATION

If more than one screen,  
show location of each on sketch.