

MISSISSIPPI DEPARTMENT OF NATURAL RESOURCES

Bureau of Land and Water Resources

Southport Mall

P.O. Box 10631

Jackson, Mississippi 39209

WATER WELL DRILLERS LOG

JACKSON
L 2050
✓

3-17-86


Coast Water Well Dr. Jackson

date well completed

firm name

county well located

LANDOWNER	Description of formations encountered	from	to
Burnice Howard	top soil	0	5
PO Box 1310	White coarse sand + Gravel	5	133
Escatawpa mo (mailing address) 3956	Blue Clay	133	193
WELL LOCATION: sec 26 T. 6 R. 6 3 miles N of ESCATAWPA (distance) (direction) (nearest town)	Gray coarse sand	193	225
WELL PURPOSE: <u>for irrigation</u> (home, irrigation, municipal, industrial)	Blue Clay	225	230
WELL COMPLETION DATA:			
(1) diameter (inches) <u>2"</u>			
(2) total depth (feet) <u>230'</u>			
(3) static water level (feet) <u>30'</u> <u>below</u> top of ground.			
(4) casing <u>PVC</u> <u>215'</u> <u>well</u> (material) (depth) <u>225'</u>			
<u>2"</u> (size) if telescope see back.			
(5) screen <u>10'</u> <u>215'</u> (length) (depth to top)			
<u>2"</u> <u>PVC</u> (size) (material)			
(6) pump <u>1/2 HP</u> <u>14</u> (HP) (yield gpm)			
<u>Electric</u> (type power)			
(7) electric log <u>no</u> (yes or no)			
(organization running log)			
(8) How well bottom plugged <u>backwater valve</u>			
DRILLERS REMARKS: <u>5-1/2" PVC tail pipe</u>			

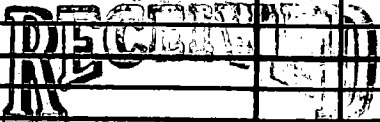


MAY 12 1986

Department of Natural Resources
BUREAU OF LAND AND WATER RESOURCES

If well telescopes please sketch and show depths.

GROUND LEVEL

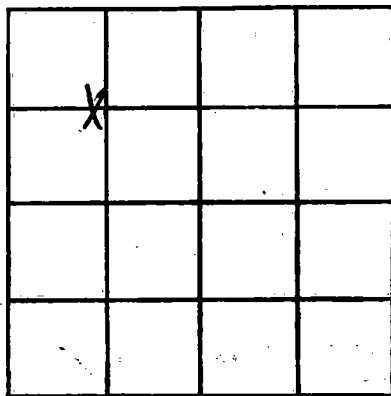

SECTION _____

Please indicate well location X.

ADDITIONAL INFORMATION

If more than one screen, show locations of each on sketch.