

MISSISSIPPI DEPARTMENT OF NATURAL RESOURCES

Bureau of Land and Water Resources

Southport Mall

P.O. Box 10631

Jackson, Mississippi 39209

WATER WELL DRILLERS LOG

JACKSON
L 2083

9-7-86 19 Coast water well Jackson
date well completed firm name county well located

LANDOWNER: James O. Murray
10425 Forest Hollow Dr.
Pascagoula Ms.
(mailing address)

WELL LOCATION:
sec 25 T 6 N R 6 E
4 1/4 miles NE of Escatawpa
(distance) (direction) (nearest town)

WELL PURPOSE: home
(home, irrigation, municipal, industrial)

WELL COMPLETION DATA:

- (1) diameter (inches) 2"
- (2) total depth (feet) 235 ft
- (3) static water level (feet) 42' below top of ground
- (4) casing PVC 220' (material), (depth)
2" (size) if telescope see back.
- (5) screen 10' 220' (length), (depth to top)
2" PVC (size), (material)
- (6) pump 1hp 9 (HP), (yield gpm)
elect (type power)
- (7) electric log yes (yes or no)
(organization running log)

(8) how well bottom plugged backwash valve

DRILLERS REMARKS:
2'-2" PVC tail pipe

description of formations encountered	from	to
	Top Soil	0
Red Clay	3	19
Blue Clay	19	53
White Coarse Sand + Gravel	53	72
Blue Clay	72	110
White Coarse Sand	110	160
Blue Clay	160	215
Gray Coarse Sand	215	230
Blue Clay	230	235
240 10 well 230		


RECEIVED

SEP 11 1986

Department of Natural Resources
Bureau of Land & Water Resources

If well telescopes please sketch and show depths.

GROUND LEVEL

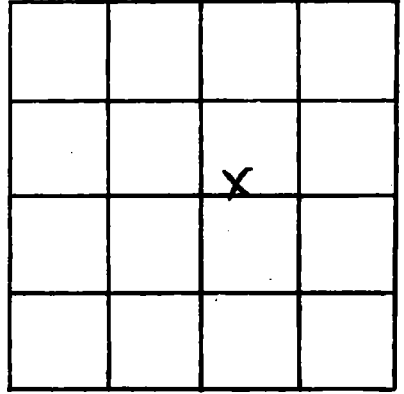

SECTION 25

Please indicate well location X.

ADDITIONAL INFORMATION

If more than one screen, show locations of each on sketch.