

MISSISSIPPI DEPARTMENT OF NATURAL RESOURCES

Bureau of Land and Water Resources

Southport Mall

P.O. Box 10631

Jackson, Mississippi 39209

COASTAL WATER WELL DRILLERS LOG

DRILLING & SERVICE CO.

RT. 11, BOX 81

BILOXI, MS 39532

Jackson  
Harrison  
county well located

JACKSON  
L 2054

Sept 1986 19  
date well completed

LANDOWNER: John Ogle  
Lot 126 Madris  
Jakes  
(mailing address)

WELL LOCATION:  
sec 10 T 6 N R 6 E  
Wiggins miles of  
(distance) (direction) (nearest town)

WELL PURPOSE: none  
(home, irrigation, municipal, industrial)

- WELL COMPLETION DATA:
- (1) diameter (inches) 4 x 2
  - (2) total depth (feet) ~~330~~ 330
  - (3) static water level (feet) 20 (below/above top of ground)
  - (4) casing PVC, 260 (material), (depth)
  - 4 x 2 (size) if telescope see back.
  - (5) screen 15' (length), 260 (depth to top)
  - 2" PVC (size), (material)
  - (6) pump 1 (HP), 10 (yield gpm)
  - ELC (type power)
  - (7) electric log no (yes or no)
  - (organization running log)
  - (8) how well bottom plugged 2" back  
WASH valve

description of formations encountered	from	to
top soil	1	2
red clay	2	25
soft blue clay	25	160
hard blue clay	160	260
fine water sand	260	270
good water sand	270	330
		160

260  
15  
---  
275  
well

RECEIVED

JUL 1 1987

Department of Natural Resources  
Bureau of Land & Water Resources


DRILLERS REMARKS:

If well telescopes please sketch and show depths.

GROUND LEVEL

160' 4" pvc casing

082

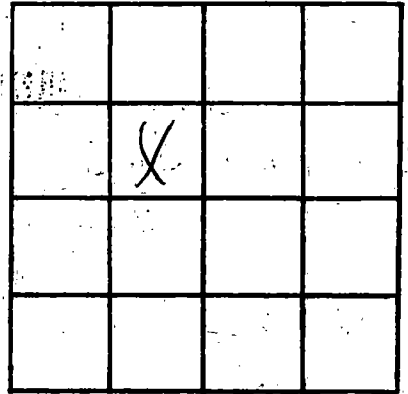

SECTION 10

Please indicate well location X.

ADDITIONAL INFORMATION

160' 2" pvc casing

15' 2" pvc screen

2" pvc back wash valve

If more than one screen, show locations of each on sketch.