

MISSISSIPPI DEPARTMENT OF NATURAL RESOURCES

Bureau of Land and Water Resources

Southport Mall

P.O. Box 10631

Jackson, Mississippi 39209

WATER WELL DRILLERS LOG

JACKSON
L 2061

date well completed 19 3-20-89 Firm name So. W. Well County well located Jackson

LANDOWNER: M. Mace  
4141 Ridge Rd  
Memphis  
 (mailing address)

description of formations encountered	from	to
<u>Sand</u>	<u>0</u>	<u>15</u>
<u>Clay</u>	<u>15</u>	<u>40</u>
<u>Sand</u>	<u>40</u>	<u>55</u>

WELL LOCATION:  
 sec. 1 T. 6 N. R. 6 E.  
10 miles N of Memphis  
 (distance) (direction) (nearest town)

WELL PURPOSE:  
 (home, irrigation, municipal, industrial)

WELL COMPLETION DATA:

(1) diameter (inches) 2"

(2) total depth (feet) 55'

(3) static water level (feet) 18 <sup>below</sup> <sub>above</sub> top of ground.

(4) casing PVC, 50  
 (material) (depth)  
2" if telescope see back.  
 (size)

(5) screen 5', 50'  
 (length) (depth to top)  
2", PVC  
 (size) (material)

(6) pump 1/2, 8  
 (HP) (yield gpm)  
AC  
 (type power)

(7) electric log NO  
 (yes or no)  
 (organization running log)

(8) how well bottom plugged BWU

RECEIVED


MAY 15 1989

Department of Natural Resources  
 Bureau of Land & Water Resources

DRILLERS REMARKS:

If well telescopes please sketch and show depths.

**GROUND LEVEL**

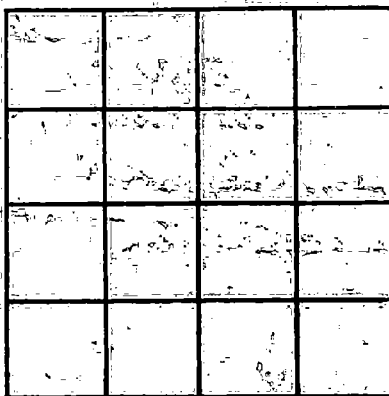

SECTION \_\_\_\_\_

Please indicate well location X.

**ADDITIONAL INFORMATION**

Multiple horizontal lines for additional information.

RECEIVED

APR 12 1983

U.S. GEOLOGICAL SURVEY  
 WATER RESOURCES DIVISION  
 BRANCH OF WATER RESOURCES

If more than one screen, show locations of each on sketch.