

MISSISSIPPI DEPARTMENT OF NATURAL RESOURCES

Bureau of Land and Water Resources

Southport Mall

P.O. Box 10631

Jackson, Mississippi 39209

WATER WELL DRILLERS LOG

RECEIVED

MAY 9 1990

JACKSON
L 2067

4/6/90
date well completed

19 Southern Water
firm name

Department of Natural Resources
County well located

LANDOWNER: Mr. Smith
Mr. & Mrs. Lt
Big Point MS
(mailing address)

description of formations encountered	from	to
clay	0	15
hard clay	15	45
sand	45	60

WELL LOCATION:
sec. 12 T. 6 N. R. 6 E.
10 miles N of Mossblint
(distance) (direction) (nearest town)


WELL PURPOSE: None
(home, irrigation, municipal, industrial)

- WELL COMPLETION DATA:
- (1) diameter (inches) 2"
 - (2) total depth (feet) 60
 - (3) static water level (feet) 12 below top of ground
 - (4) casing PVC 55' (material) (depth)
 - (size) If telescope see back.
 - (5) screen 5' 55' (length) (depth to top)
 - 2" PVC (size) (material)
 - (6) pump 1 (HP) 12 (yield gpm)
 - AL (type power)
 - (7) electric log NO (yes or no)
 - N/A (organization running log)
 - (8) how well bottom plugged BWV

DRILLERS REMARKS:

If well telescopes please sketch and show depths.

GROUND LEVEL

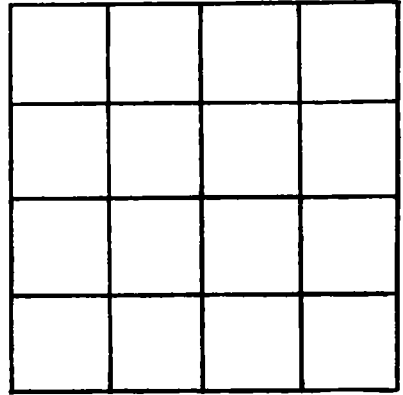

SECTION _____

Please indicate well location X.

ADDITIONAL INFORMATION

If more than one screen, show locations of each on sketch.